

Name Pasquale Luongo

Service No. 1065

Address 8 Spencer Street

Lexington, Mass.

Location 8 Spencer Street

Kind of Pipe

Size 6"

Size of Main 8"

~~Repair~~ ~~Renewal~~ - New Service

Location

Date	Material	Amount	Total	Date		Amount
Apr. 24, '47	Labor	48 80		<i>April 22 47</i>	<i>Deposited</i>	110 00
Apr. 25, '47	"	<u>2 05</u>	50 85	<i>May 22 47</i>	<i>Refunded</i>	39 38
	10% Overhead		5 09			70 42
	32' - 6" Sewer Pipe @.24		7 68			
	1 - 6" 1/8 Bend		1 28			
	Joint Compound		1 92			
	Cement 2 bags @ 1.05		2 10			
	Trucking 2 hrs. @.75		<u>1 50</u>			
			70 42			
	<b>Labor</b>					

TOWN OF LEXINGTON—DEPT. OF PUBLIC WORKS

SEWER DIVISION

DATE .....

NO. ....


The undersigned applies for the construction of a particular sewer connecting No. ....  
Street and hereby agrees to comply with the Rules and Regulations governing the construction and use of Particular  
Sewers, as now or at any future time established by the Board of Selectmen.

Am't of estimate \$.....

Am't Paid \$.....

..... Owner

Sketch of Service Here

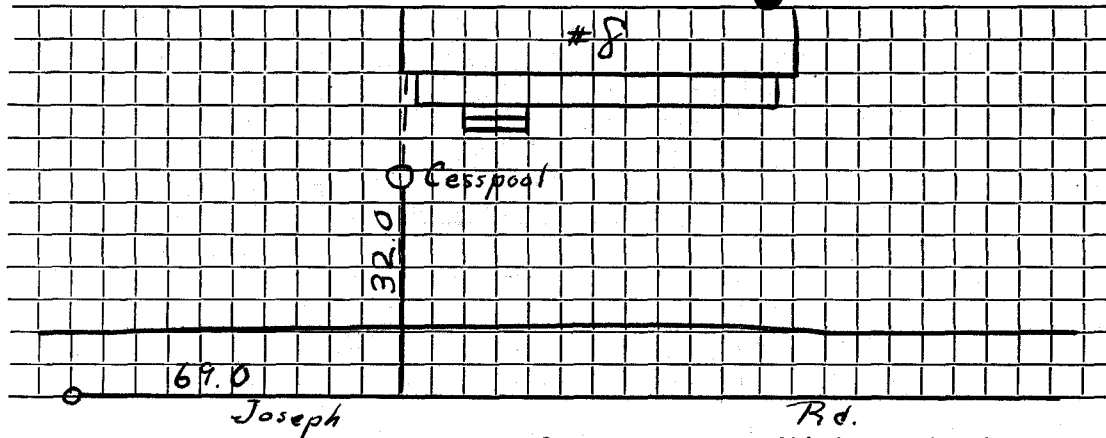

Connection made in ..... Street.

Work completed ..... 19..

Remarks: