

Name R. G. Lawrence

Service No. 87

Address 9 Spencer Street

Exington, Mass.

Location 9 Spencer Street

Kind of Pipe

Size

Size of Main

~~Repair~~ ~~Renewal~~ New Service

Com. 12-31-49

Location

Date	Material	Amount	Total	Date	Amount
Dec. 12, '49	Labor	33 43	33 43	Nov. 25 '49	10000
	10% Overhead		3 34	Dec 31 '49	78
	24' - 6" Sewer Pipe @.26		6 24		99 22
	Joint Compound		1 44		
	Littlefield Shovel 2 hrs. @7.00		14 00		
	Trucking 2 hrs. @.75		1 50		
			59 95		
May 12, '47	Labor		22 62		
May 13, '47	Labor		6 00	Installed to curb in 1947	
	10% Overhead		2 86		
	18' - 6" Sewer Pipe @.26		4 68		
	1 - 6" 1/8 Band		1 28		
	Labor Joint Compound		1 08		
	Trucking 1 hr. @.75		75		
			39 27		
			99 22		

TOWN OF LEXINGTON—DEPT. OF PUBLIC WORKS

SEWER DIVISION

DATE

NO.

The undersigned applies for the construction of a particular sewer connecting No.
Street and hereby agrees to comply with the Rules and Regulations governing the construction and use of Particular
Sewers, as now or at any future time established by the Board of Selectmen.


Am't of estimate \$.....

Am't Paid \$.....

..... Owner

Sketch of Service Here

9

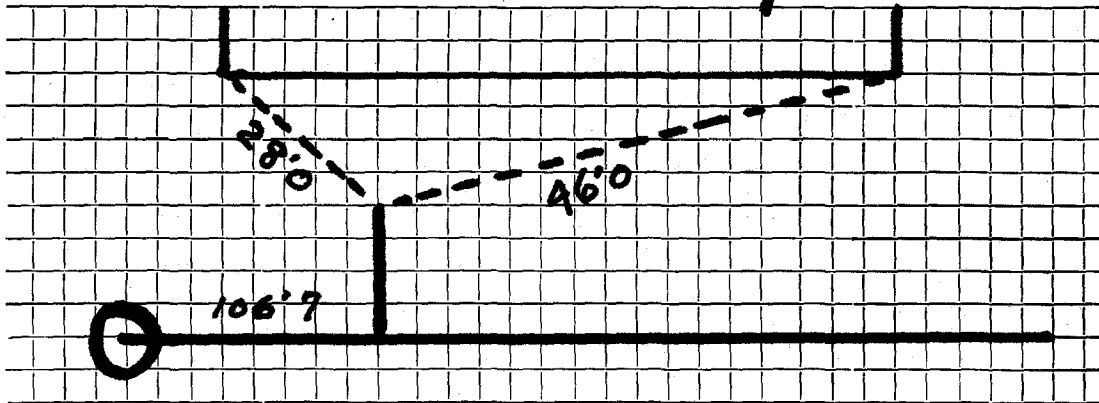

Connection made in Street.

Work completed 19..

Remarks: