

Name Harold Cornish

Service No. 108

Address 104 Spring Street

104 Spring ST.

Location

Kind of Pipe

con. 8-15-55

Size 6"

Size of Main 8"

~~Repair~~ ~~Renewal~~ New Service

com. 8-15-55

Location

Date	Material	Amount	Total	Date	Amount
6/30/55	Labor	70 20		6-6-55	Deposited 175 00
7/1/55	Labor	14 04		8-15-55	Refunded 9 34
		84 24			165 66
	10% Overhead	8 42	92 66		
	50'-6" sewer Pipe @ .32		16 00		
	Joint Compound		3 00		
	7 hrs. Littlefield Shovel @ 7.50		52 50		
	2 hrs. trucking @ .75		1 50		
			165 66		
	Labor				

TOWN OF LEXINGTON—DEPT. OF PUBLIC WORKS

SEWER DIVISION

DATE

NO.


The undersigned applies for the construction of a particular sewer connecting No.
Street and hereby agrees to comply with the Rules and Regulations governing the construction and use of Particular
Sewers, as now or at any future time established by the Board of Selectmen.

Am't of estimate \$.

Am't Paid \$.

..... Owner

Sketch of Service Here

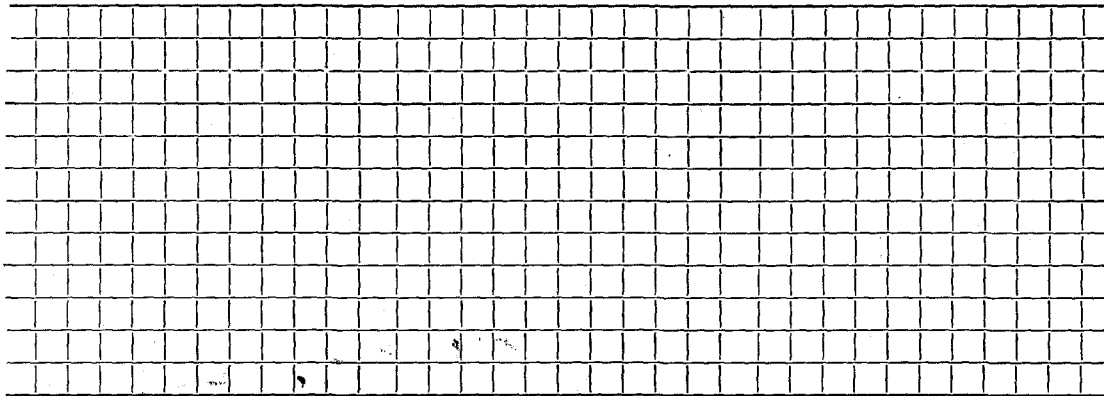

Connection made in Street.

Work completed 19..

Remarks: