

Name Francis J. Zucker

Service No.

54

Address 107 Spring Street

107 Spring ST.

Location

Kind of Pipe

Size 6"

Size of Main 8"

~~Replaces Existing~~ New ServiceLocation *Concl 7-5-60*


Date	Material	Amount	Total	Date	Amount
5-9-60	Labor	79.50		4-26-60	200 00
5-10-60	"	82.68	162 18	8-23-60	82 58
	10 % O.H.	16 22	178 40		182 58
60'	6" Transite Pipe @ .78		46 80		
1	6" Clay Elbow		1 88		
					NON CHARGE
3	Hrs. Town Shovel @ 6.50		19 50		Labor 9 54
3	Hrs. Trucking @ 3.00		9 00		Waiting for Shovel
1	Hr. Trailer @ 3.00		3 00		
1	Hr. Trojan Loader @ 3.00		3 00		
	21x3 Patch		21 00		
			282 58		
				<i>Bill sent 7-5-60</i>	<i>82.58</i>



DATE \_\_\_\_\_

TOWN OF LEXINGTON — BOARD OF PUBLIC WORKS  
SEWER DIVISION

Sketch of Service Here

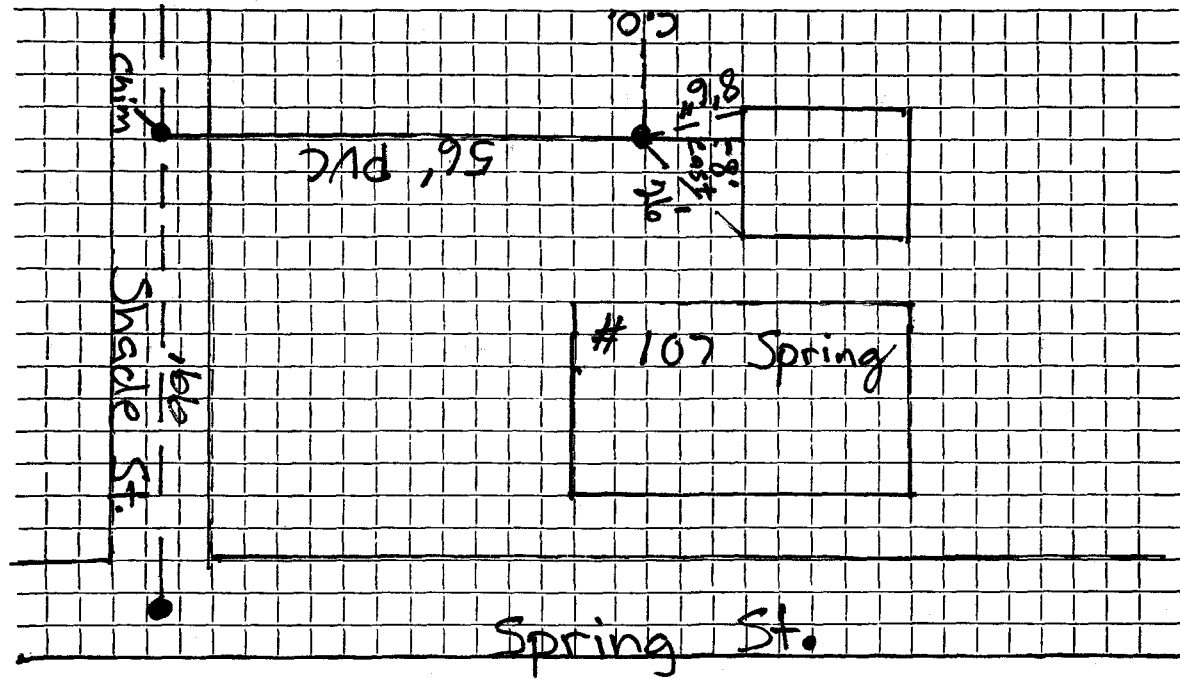

Connection made in ..... Street. Work completed .....

Remarks: .....  
.....  
.....

DATE \_\_\_\_\_

**TOWN OF LEXINGTON — BOARD OF PUBLIC WORKS**

**SEWER DIVISION**

Sketch of Service Here

A large rectangular area filled with a grid of small squares, intended for drawing a sketch of sewer service. The grid consists of approximately 20 columns and 20 rows of squares.

Connection made in ..... Street.                      Work completed .....

Remarks: .....  
.....  
.....