

Name A. Clifford Fletcher

Service No. <sup>229</sup> 112 (1957)

Address 112 Spring Street

112 Spring ST.

Location Comm. 6-2-58

Kind of Pipe

Size 6"

Size of Main 8"

-Repair—Renewal—New Service

Location

Date	Material	Amount	Total	Date	Amount
1/20/58	Labor	83 54		12-12-57	Deposit \$ 300 00
1/21/58	"	27 00		6-13-58	Pd by ref of S.H.C. #229 18 20
1/22/58	"	61 44		1-24-59	Paid 25 00
1/23/58	"	93 24		10-3-59	" NON CHARGE 25 00
		265 22		11-9-59	" NON CHARGE 18 57
	10% overhead	26 52	291 74	1/14/58	Labor (over) 17 70
	77' - 6" Transite Pipe @ .702		54 02	1/24/58	" 70 38
	50 lbs. Dynamite @ .26		13 00	1/25/58	" 6 01
	50 Caps @ .21		10 50	1/29/58	" 18 66
	13 hrs. Town Shovel @ 6.50		84 50	1/30/58	" 106 39
	8 hrs. Trucking @ .75		6 00	1/31/58	" 28 59
	6 hrs. Compressor @ 3.00		18 00		
	33 1/2 hrs Fill @ .70		23 10	4 hrs. Town Shovel @ 6.50	26 00
	1 - 22 1/2 Bend		6 21	2 hrs. Trucking @ .75	1 50
			507 07	1-27-60	Paid 25 00
				3-9-60	" 25 00
				7-21-60	" 25 00
				12-30-60	" 25 00
				3-7-61	" 17 28 90
					1507 07

**TOWN OF LEXINGTON—DEPT. OF PUBLIC WORKS**  
**SEWER DIVISION**

DATE.....

NO. ....

The undersigned applies for the construction of a particular sewer connecting No.....  
Street and hereby agrees to comply with the Rules and Regulations governing the construction and use of Particular  
Sewers, as now or at any future time established by the Board of Selectmen.


Am't of estimate \$.....

Am't Paid \$.....

..... Owner

---

**Sketch of Service Here**

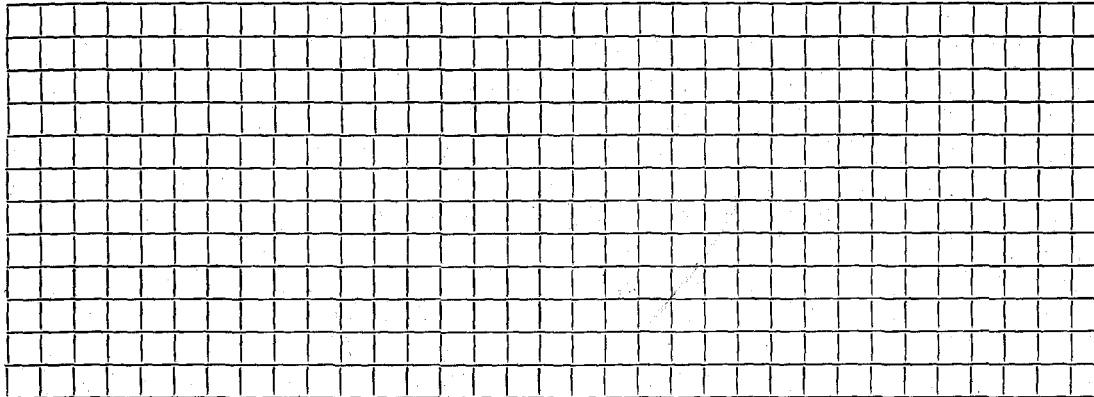

Connection made in..... Street.

Work completed.....19..

Remarks: