


DATE JUNE 8 1998

TOWN OF LEXINGTON — BOARD OF PUBLIC WORKS
SEWER DIVISION

Sketch of Service Here

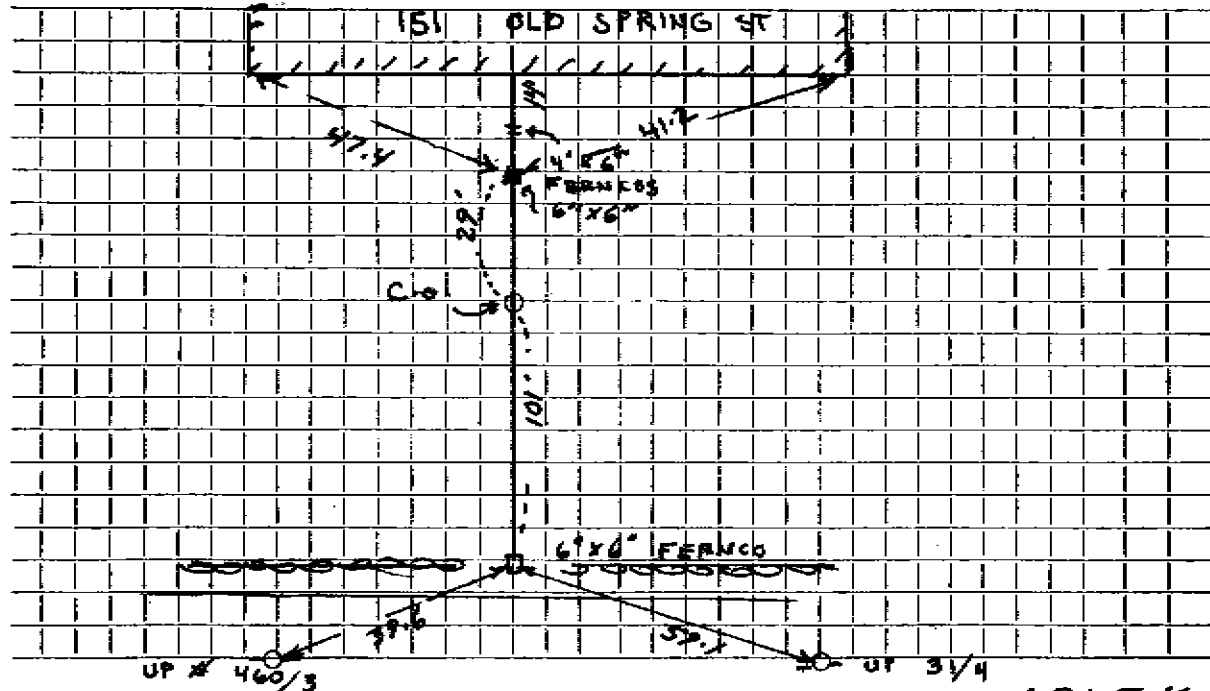

Connection made in Street. Work completed ARLEX OIL CO.

Remarks: OLD SPRING STREET

..... BK 98-2

..... TJM