




DATE OCT 21 1998

TOWN OF LEXINGTON — BOARD OF PUBLIC WORKS  
SEWER DIVISION

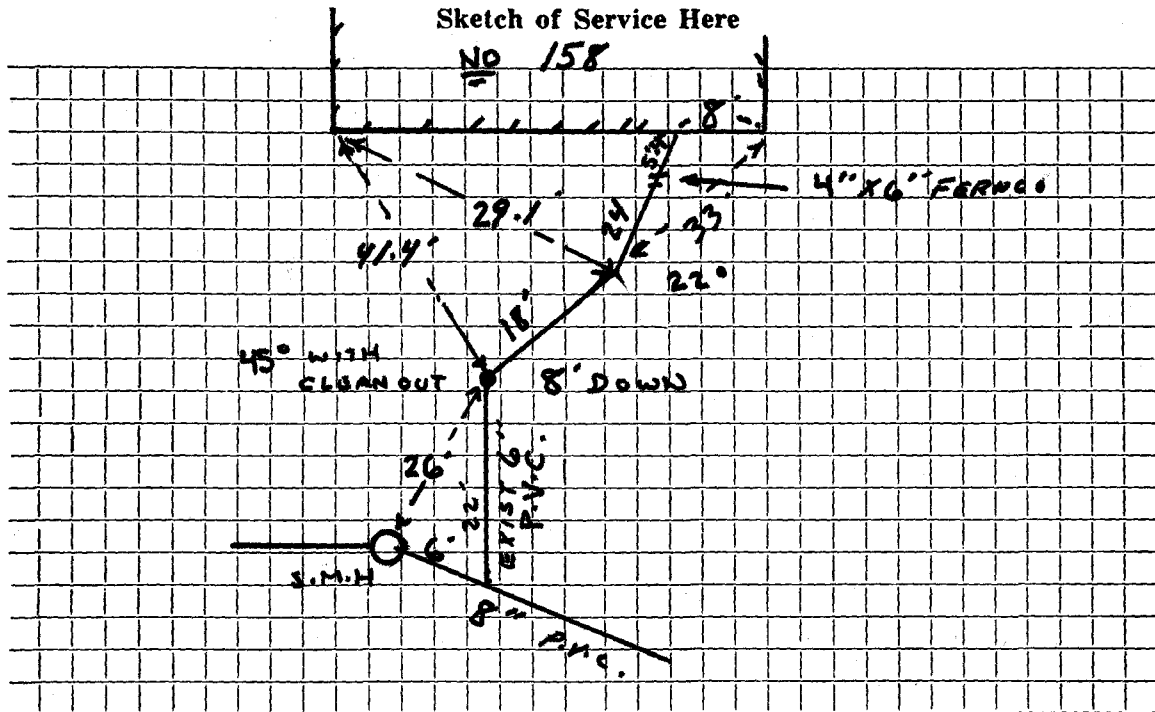

Connection made in SPRING ST Street. Work completed SEAN S. TOSCI

Remarks: .....

..... FIELD BOOK 98-2 ..... T.M.