


DATE 3.11.98

TOWN OF LEXINGTON — BOARD OF PUBLIC WORKS
SEWER DIVISION

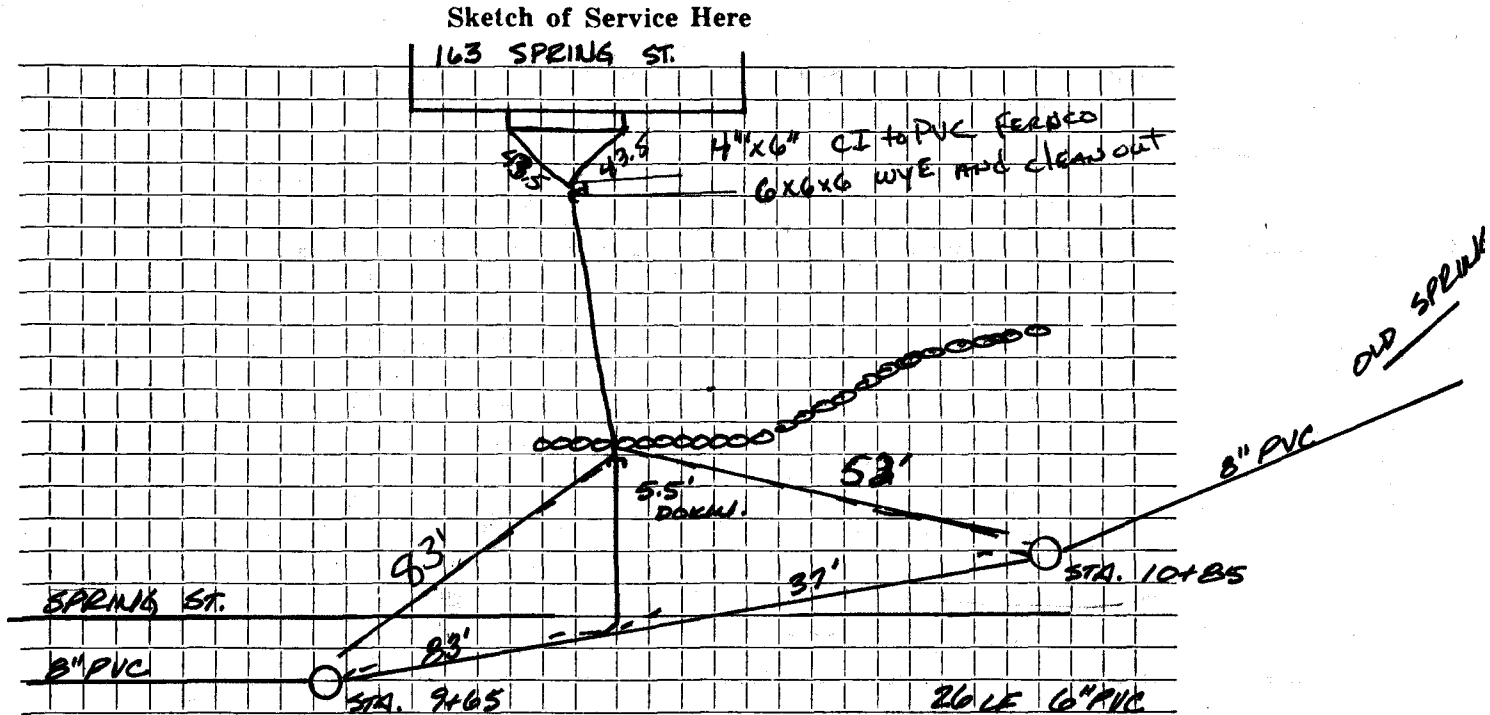

Connection made in SPRING Street. Work completed CONTRACT 97-4

Remarks: