




DATE \_\_\_\_\_

TOWN OF LEXINGTON — BOARD OF PUBLIC WORKS

SEWER DIVISION

Sketch of Service Here

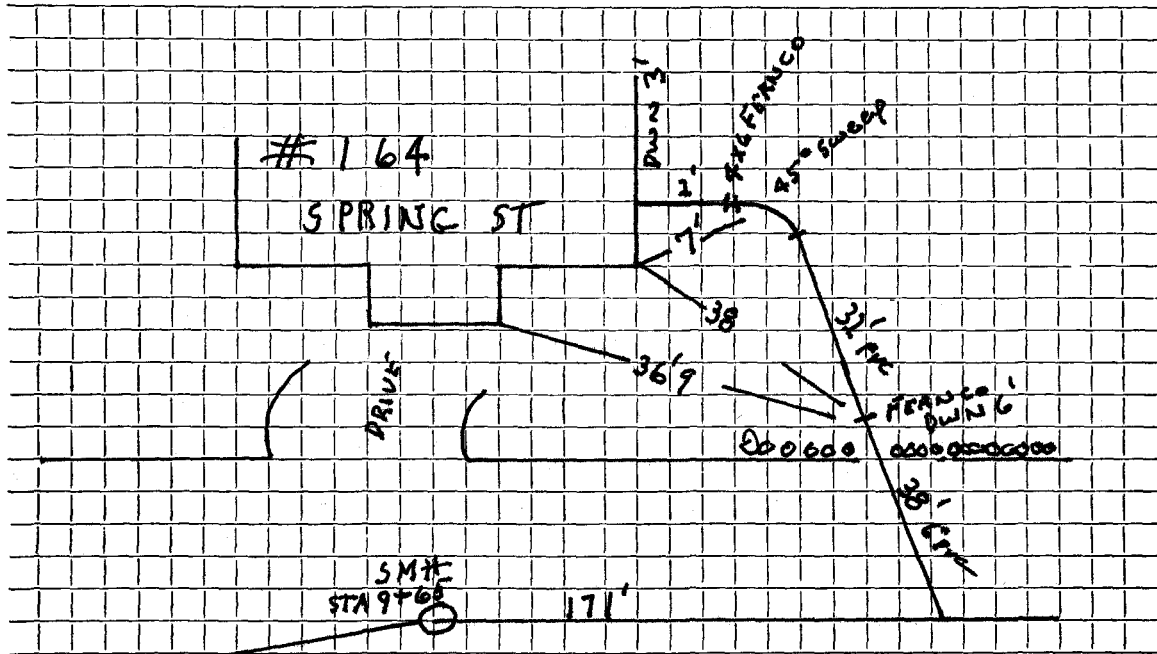

Connection made in \_\_\_\_\_ Street. Work completed ..... CONTRACT 97-4

Remarks: 3' of PVC Removed FROM OUTSIDE TO GET ANGLE. ....

.....  
.....