


DATE 3.23.98

TOWN OF LEXINGTON — BOARD OF PUBLIC WORKS
SEWER DIVISION

Sketch of Service Here

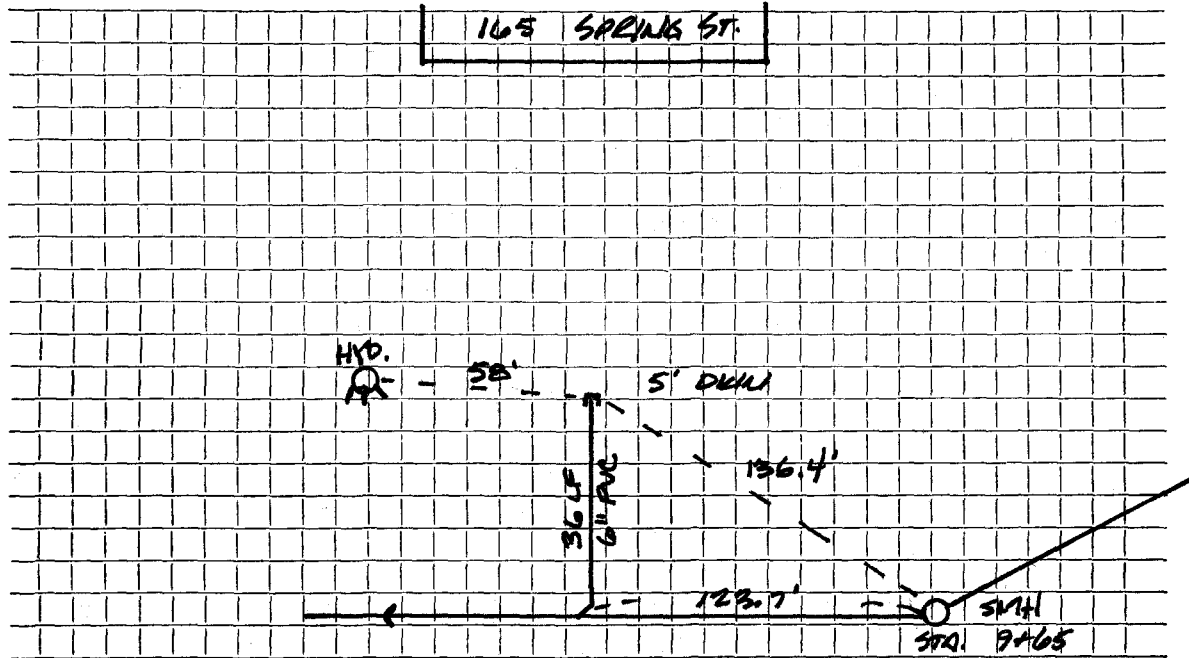

Connection made in SPRING Street. Work completed CONTRACT 97-4

Remarks:
.....
.....