




DATE \_\_\_\_\_

TOWN OF LEXINGTON → BOARD OF PUBLIC WORKS

SEWER DIVISION

Sketch of Service Here

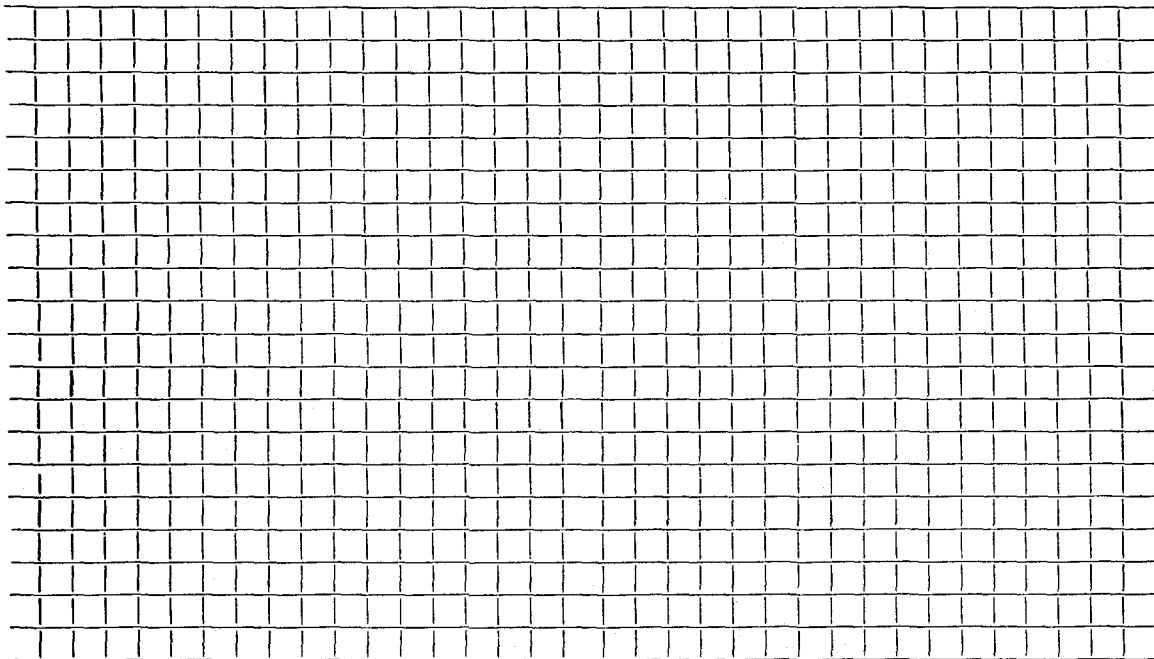

Connection made in ..... Street. Work completed .....

Remarks: *Original Service 3-26-57 (61'-6" Sewer Pipe)* .....

.....  
.....