


DATE 9/08/88

TOWN OF LEXINGTON — BOARD OF PUBLIC WORKS
SEWER DIVISION

Sketch of Service Here **20**

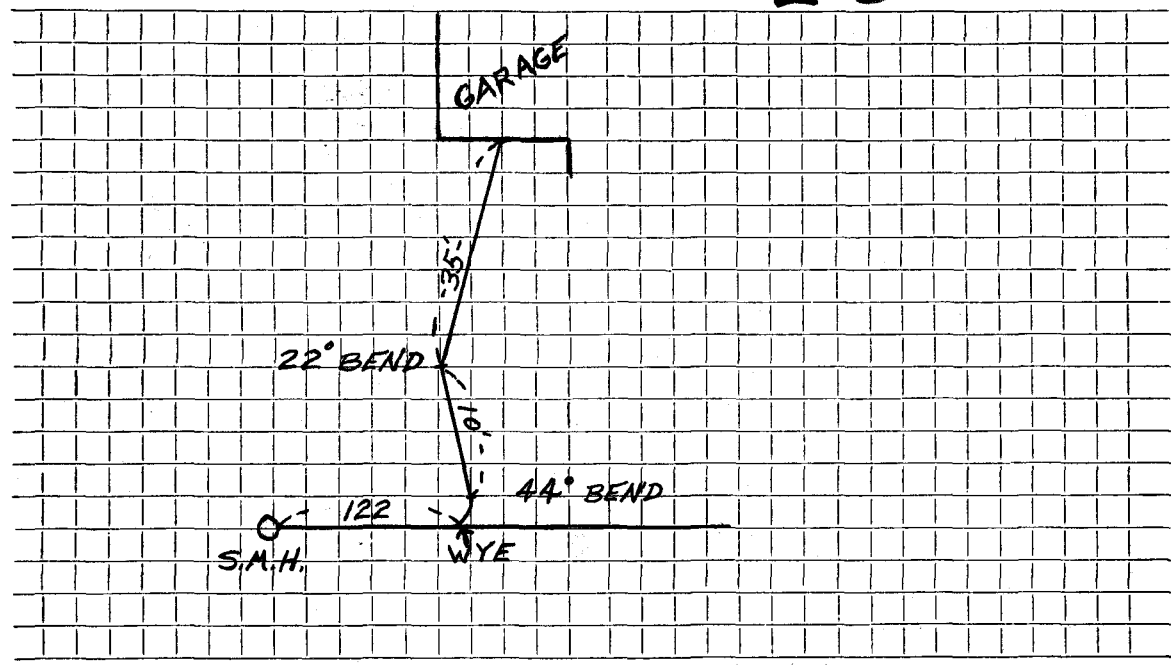

Connection made in ... SPRING ST. Street. Work completed

Remarks:
.....
.....