

Name William G. Little 742-3200

Service No. 7  
JUL 24 1978

Address 24 Spring Street

24 Spring ST.

Location

Kind of Pipe

Size 6"

Size of Main 8"

W.O. #6176 Trebino #3320

Location


Date	Material	Amount	Total	Date	Amount
4/20/78	Labor	440.97		4-6-78	Deposit 250.00
	Police	61.75	502.72	10-11-78	Rebate 357.73
	10% O.H.	50.27	552.99	11-27-78	Paid 254.47
30'	6" Transite pipe @1.50		45.00		494.47
1	45° Bend		10.40		
1	6" Cap		3.80		
6	yds. Gravel @2.44		14.64		
1/2	bag Cement		1.63		
12	Red Brick @.12		1.44		
2	Ton Gold Patch @15.90		31.80		
3 1/2	hrs. Trucking @3.00		10.50		
4	hrs. Backhoe @6.50		26.00		
3 1/2	hrs. Loader @4.00		14.00		
	9' x 20' Hot top		120.00		
			832.20		

DATE \_\_\_\_\_

TOWN OF LEXINGTON — BOARD OF PUBLIC WORKS

SEWER DIVISION

Sketch of Service Here **24**

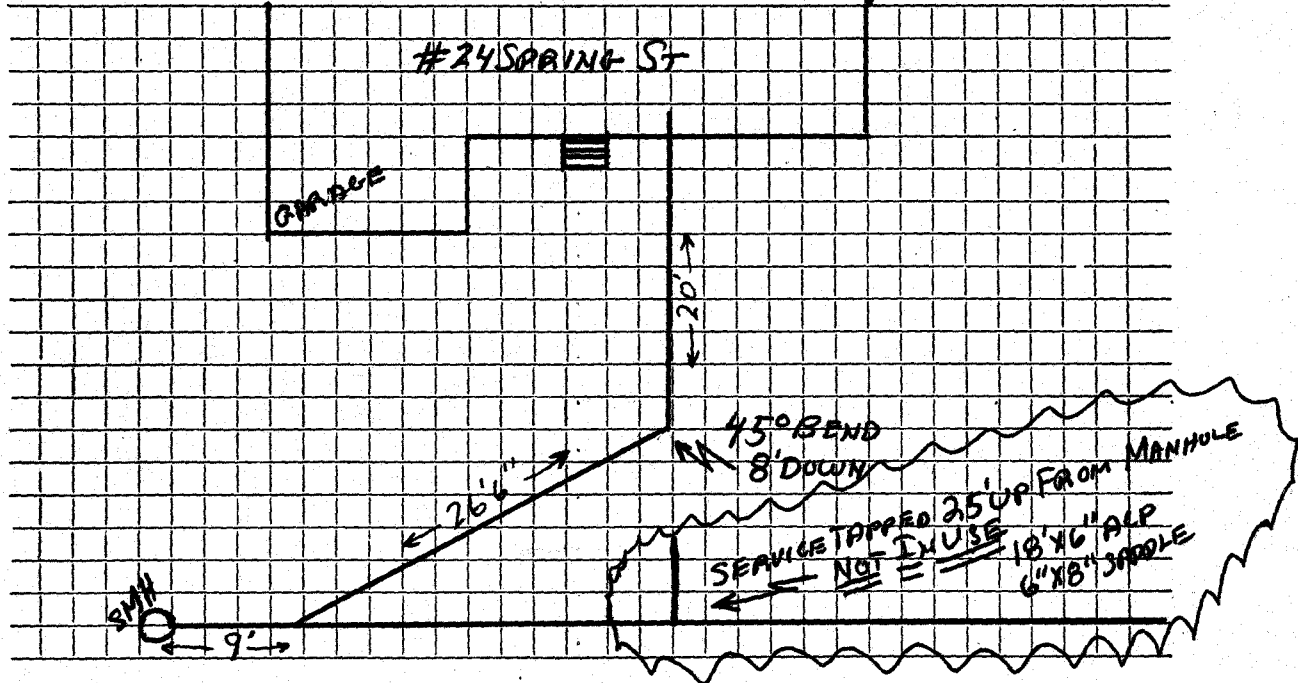

Connection made in ..... Street. Work completed .....

Remarks: .....  
.....  
.....