

Name Frank R. Warren

Service No. 70

Address 26 Spring Street

26 Spring ST.

Location

Kind of Pipe

Size 6"

Size of Main 8"

~~Repair/ Renewal~~ New Service Suburbanite Cesspool Permit #313 - W.O. #446

Location MAR 14 1966


Date		Material	Amount		Total		Date		Amount	
6-21-65		Labor	109	10			6-3-65	Deposit	150	00
		10% O.H.	10	91	120	01	1-17-67	Paid	35	66
	20'	6" Transite pipe @ .82			16	40			185	66
	1	8 x 6 Wye Saddle			5	25				
		12 x 3 Patch			12	00				
	2	Hrs Town Truck @ 3.00			6	00				
	4	Hrs Tractor @ 6.50			26	00				
					185	66				
6/22/65	27'	6" Transite pipe								
								Bill sent 35.66		

DATE \_\_\_\_\_

TOWN OF LEXINGTON — BOARD OF PUBLIC WORKS

SEWER DIVISION

Sketch of Service Here **26**

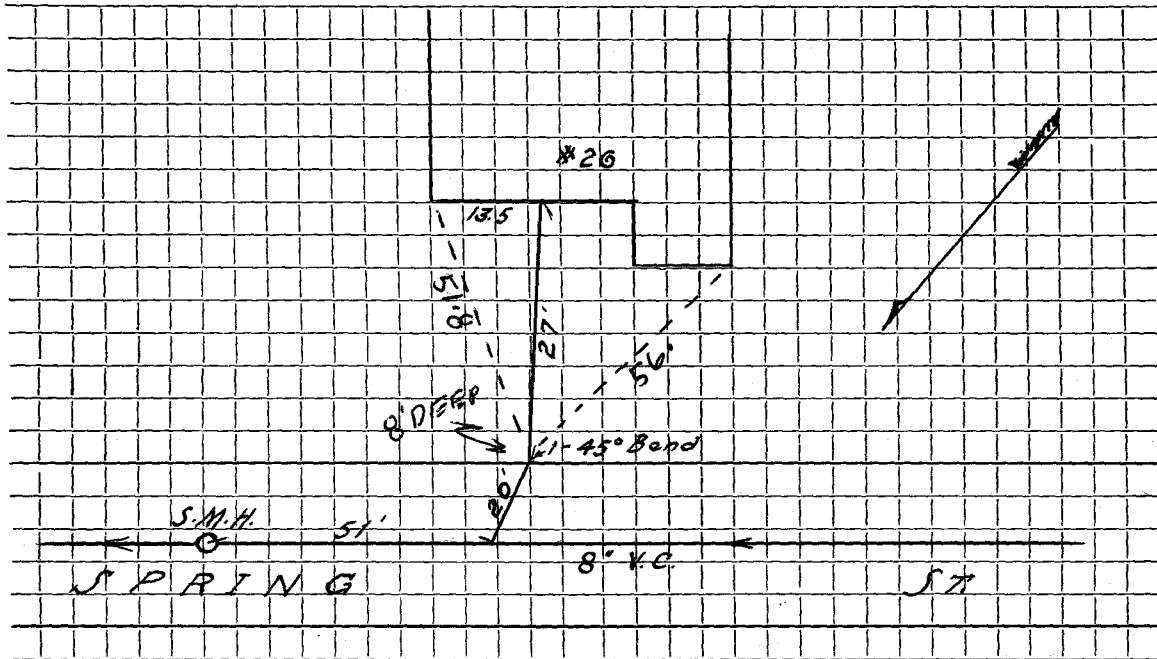

Connection made in ..... Street. Work completed .....

Remarks: .....  
.....  
.....