

Name Robert Ericson

Service No. 183

Address 34 Spring Street

34 Spring ST.

Location

Kind of Pipe

Size 6"

Size of Main 8"

~~Repair/ Renewal~~ — New Service

Location Comm 12-31-61

Date	Material	Amount	Total	Date	Amount
12/13/61	Labor	67 36		11-30-61	200 00
	10% O.H.	6 74	74 10	12-31-61	41 22
	49' 6" Transite Pipe @ .72		35 28		158 78
	1 6" 90° Transite Elbow		5 40		
	2 Hrs. Town Shovel @ 6.50		13 00		
	2 Hrs. Trucking @ 3.00		6 00		
	1 Hr. Loader @ 3.00		3 00		
	22 X 3 Patch		22 00		
			158 78		
	Extension - Arlex #4986				
8/12/87	54' 4" PVC				
	Labor				

TOWN OF LEXINGTON—DEPT. OF PUBLIC WORKS
SEWER DIVISION

DATE.....

NO.


The undersigned applies for the construction of a particular sewer connecting No.....
Street and hereby agrees to comply with the Rules and Regulations governing the construction and use of Particular
Sewers, as now or at any future time established by the Board of Selectmen.

Am't of estimate \$.....

Am't Paid \$.....

..... Owner

Sketch of Service Here

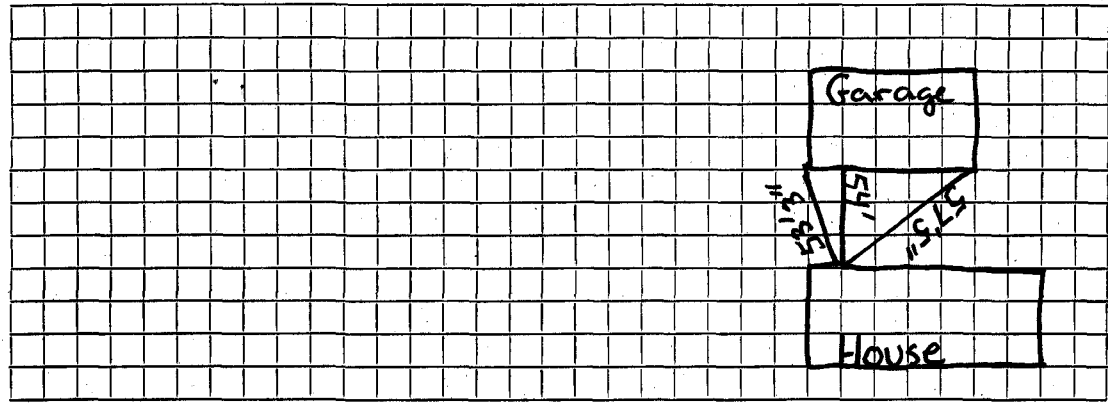

Connection made in..... Street.

Work completed.....19..

Remarks: