

Name Harry J. &amp; Anita G. Haroutunian

Service No. 187

Address 35 &amp; 37 Spring Street

35-37 Spring ST.

Location

Comm. 12-2-57

Kind of Pipe

Size 6"

Size of Main 8"

~~Repair~~ ~~Renewal~~ New Service

Location

Date	Material	Amount	Total	Date	Amount
10/24/57	labor	21 27		10-11-57	Deposit \$ 200 00
10/25/57	"	61 44		12-2-57	Refund 45 12
		82 71			\$ 154 88
	10% overhead	8 27			
			90 98		
	42' 6" transite @ .70		29 40		
	2 6" Clay pipe @ .435		87		
	1 6" clay elbow		1 88		
	3 hrs. town shovel @ 6.50		19 50		
	3 hrs trucking @ 75		2 25		
	10' x 3 Patch		10 00		
			154 88		
	Labor				

**TOWN OF LEXINGTON—DEPT. OF PUBLIC WORKS**  
**SEWER DIVISION**

DATE.....

NO. ....

The undersigned applies for the construction of a particular sewer connecting No.....  
Street and hereby agrees to comply with the Rules and Regulations governing the construction and use of Particular  
Sewers, as now or at any future time established by the Board of Selectmen.


Am't of estimate \$.....

Am't Paid \$.....

..... Owner

---

**Sketch of Service Here**

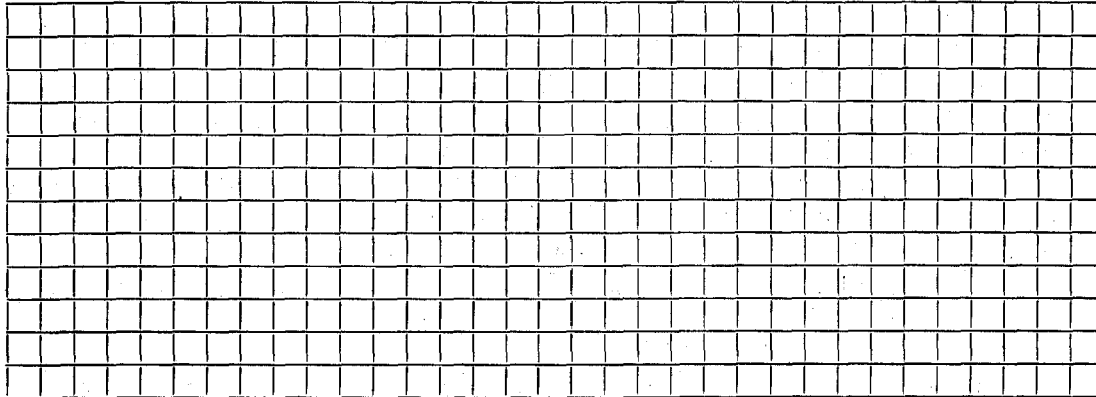

Connection made in..... Street.

Work completed.....19..

Remarks: