

Name L.H.Hewett Jr., Inc.

Service No. 87

Address 39 Spring Street

39 Spring ST.

Location

Kind of Pipe

Size 6"

Size of Main 8"

~~Repair~~ ~~Renewal~~ New Service

Hewett #3492 W.O.#851

Location

JUL 7 1980

Date	Material	Amount	Total	Date	Amount
12-11-79	Labor	160.08		10-31-79	220.00
	Police	72.00	232.08	7-7-80	150.46
	10% O.H.	23.21	255.29		420.46
10'	6" Transite @1.62		16.20		
1	2' Nipple		6.46		
2	5' Nipple @2.00		20.00		
1	90° Elbow		9.28		
1	11½° Elbow		6.80		
1	6x8 Saddle		27.50		
1	6" Plug		3.91		
3	hrs. Trucking @3.00		9.00		
4	hrs. Backhoe @6.50		26.00		
	Hot Top 4' x 15'		40.02		
			420.46		
1-7-80	99½' 6" Transite pipe				
	10' 4" Cast Iron pipe				

Billed 150.46


✓

DATE _____

TOWN OF LEXINGTON — BOARD OF PUBLIC WORKS

SEWER DIVISION

Sketch of Service Here **39**

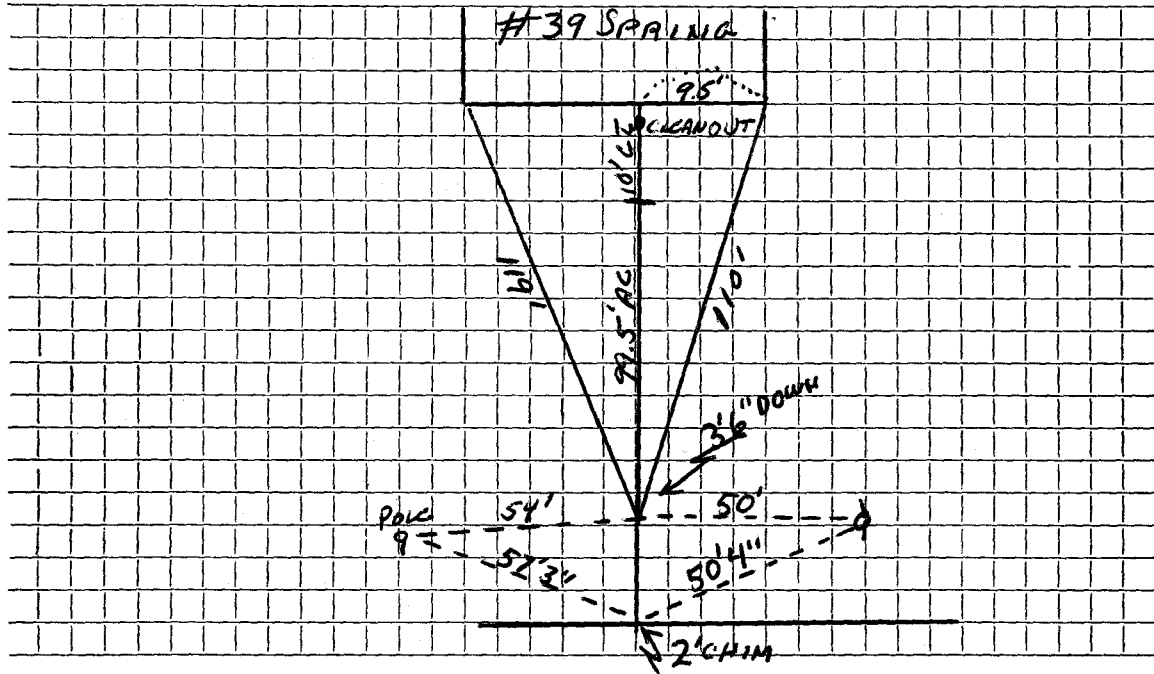

Connection made in Street. Work completed

Remarks:
.....
.....