

Name Donald Green

Service No. 119

Address 45 Spring Street

45 Spring ST.

Location

Kind of Pipe

Size 6"

Size of Main 8"

~~Repair-Renewal~~ New Service W.O. #7509

Location Comm 10-29-62


Date	Material	Amount	Total	Date	Amount
8-21-62	Labor	30.54			
8-22-62	"	67.85	98.39	8-7-62	Deposit 250 00
	10% O.H.	9.84	108.23	10-29-62	Re-Summed 33 88
	56' 6" Transite pipe @82		45.92		216 12
	1 6" Clay Elbow		1.88		
	1 11 ¹ / ₄ " Transite Bend		4.09		
	15X3 Patch		15.00		
	4 Hrs. Town Shovel @6.50		26.00		
	5 Hrs. Trucking @3.00		15.00		
			216.12		

DATE _____

TOWN OF LEXINGTON — BOARD OF PUBLIC WORKS

SEWER DIVISION

Sketch of Service Here

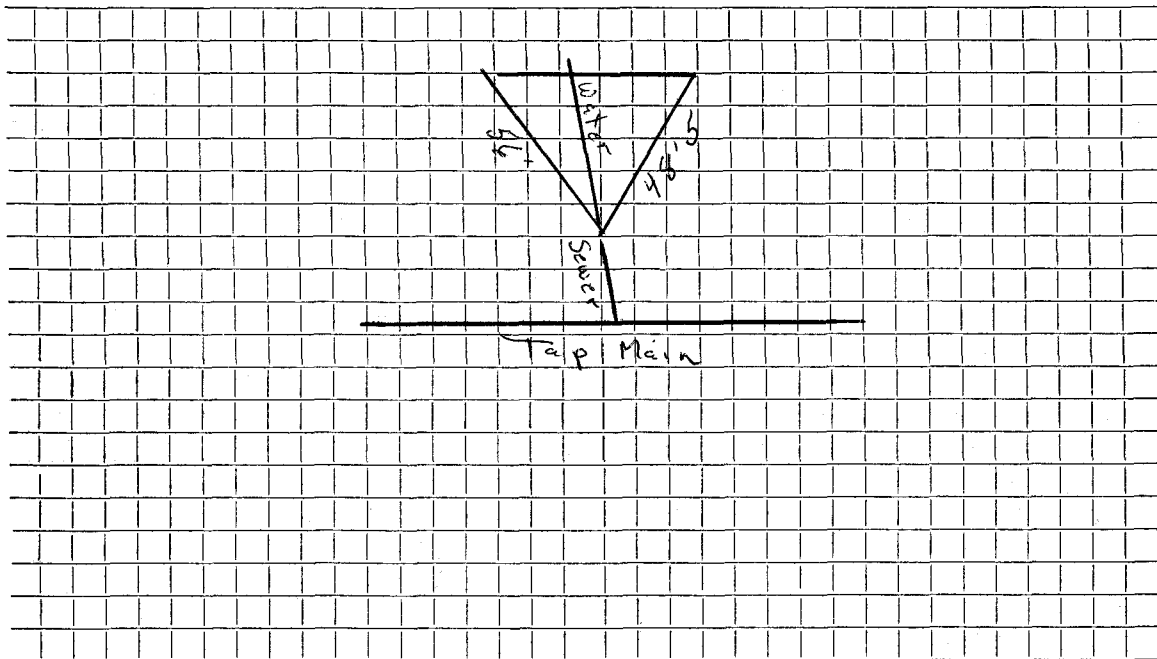

Connection made in Street. Work completed

Remarks:
.....
.....