


DATE _____

TOWN OF LEXINGTON — BOARD OF PUBLIC WORKS
SEWER DIVISION

Sketch of Service Here **46**

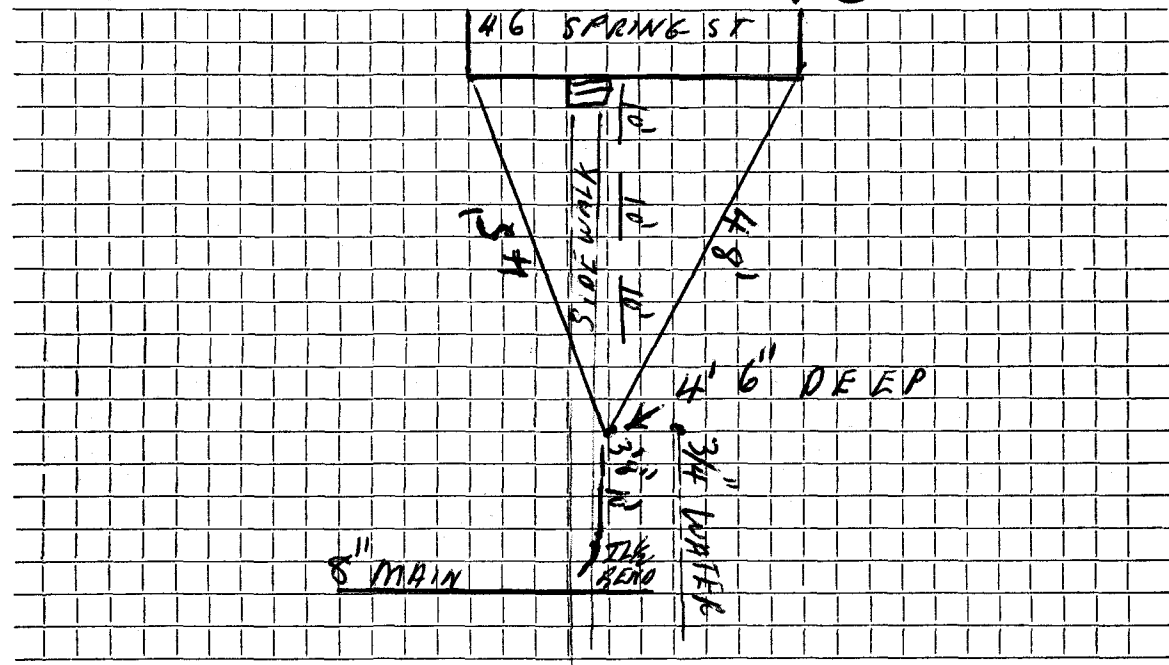

Connection made in Street. Work completed

Remarks: Original Service 5-6-55 (56'-6" Sewer Pipe, 1-6"-1/8" Bend.)