

Name E. G. Blomquist

Service No. 51

Address 47 Spring Street

47 Spring ST.

Location

Kind of Pipe

Size 6"

Size of Main 8"

~~Repair/Rebuild~~ — New Service

com. 7-18-55

Location

Date	Material	Amount	Total	Date	Amount
5/2/55	Labor	109 67		4-20-55	200 00
	10% overhead	10 97	120 64	7-18-55	(23 14)
	88' - 6" sewer pipe @ .32		28 16		176 86
	1 - 6x6 Y		1 28		
	joint compound		5 28		
	4 hrs. town shovel @ 5.00		20 00		
	2 hrs. trucking @ .75		1 50		
			176 86		
	Labor				

TOWN OF LEXINGTON—DEPT. OF PUBLIC WORKS
SEWER DIVISION

DATE.....

NO.


The undersigned applies for the construction of a particular sewer connecting No.....
Street and hereby agrees to comply with the Rules and Regulations governing the construction and use of Particular
Sewers, as now or at any future time established by the Board of Selectmen.

Am't of estimate \$.

Am't Paid \$.

..... Owner

Sketch of Service Here

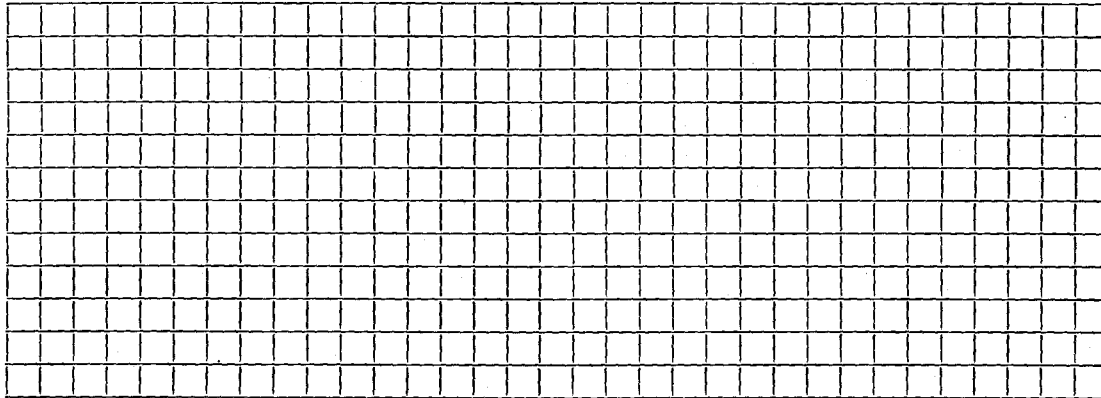

Connection made in..... Street.

Work completed..... 19..

Remarks: