

Name Joseph Johnson

Service No. 51

Address 51 Spring Street

*604-7660*

*51 Spring ST.*

Location

Kind of Pipe

Size *6"*

Size of Main *8"*

~~Repair~~ ~~Renewal~~ New Service

*Watt 8677*


Location **JUN 29 1964**

Date	Material	Amount	Total	Date	Amount
5/27/64	Labor	126.01		7-11-64	<i>Deposit</i> 300.00
5/28/64	"	93.85	219.86	1-29-64	<i>Paid by VHC #28</i> 1.97
	10% O.H.	21.99	241.85	10-29-64	<i>Paid</i> 59.59
	55' <i>6"</i> Transite Pipe @ .82		45.10		
	1 11 $\frac{1}{4}$ <sup>o</sup> Transite Bend		4.09		
	1 Bag Cement		1.50		
	2 Yards Loam @ 2.00		4.00		
	15 X 3 Patch		15.00		
	8 Ton Crusher Run @ 1.50		12.00		
	4 Hrs. Town Shovel @ 6.50		26.00		
	4 Hrs. Trucking @ 3.00		12.00		
			361.54		
					<i>Bill sent 59.59</i>

DATE \_\_\_\_\_

**TOWN OF LEXINGTON — BOARD OF PUBLIC WORKS**  
**SEWER DIVISION**

Sketch of Service Here

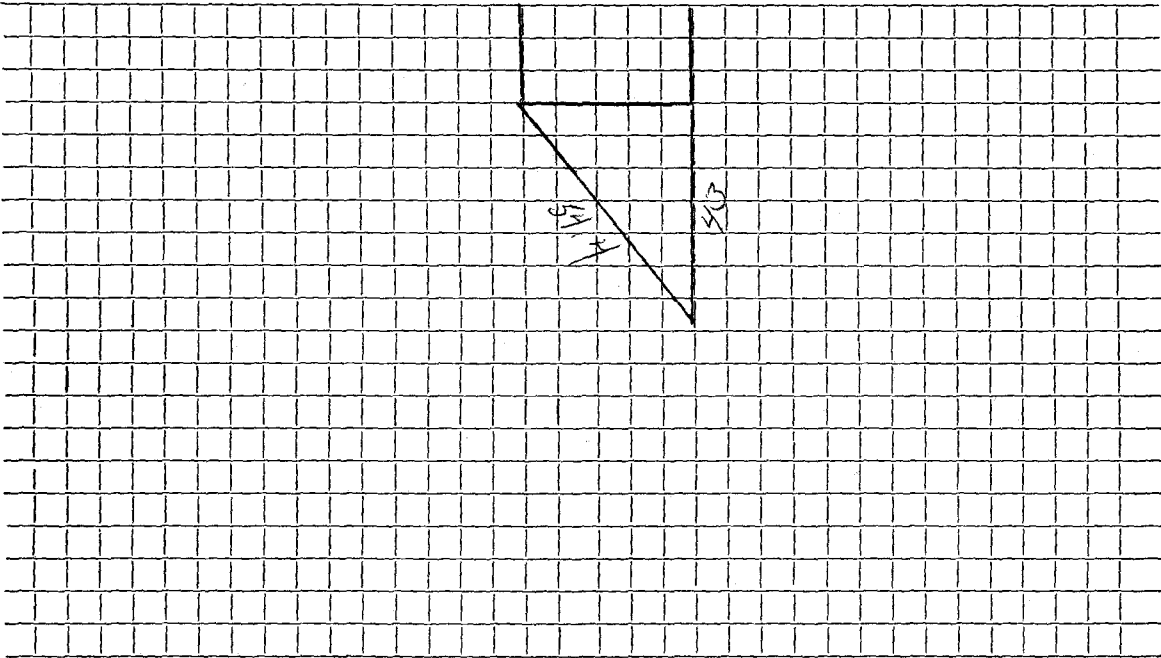

Connection made in ..... Street. Work completed .....

Remarks: .....  
.....  
.....