

Name Martha Kermatti

Service No. 18

Address 53 Spring Street

53 Spring ST.

Location

Kind of Pipe

Size 6"

Size of Main 8"

~~Reservoir~~ New Service W.O. #374 Richard Noyes #3384

Location MAY 21 1979

Date	Material	Amount	Total	Date	Amount
5-8-79	Labor	151.08		4-23-79	350.00
	10% O.H.	15.11	166.19		14.36
	20' 6" Transite pipe @1.91		38.20		335.64
	1 6" x 8" Saddle		22.29		
	1 2' Nipple		6.11		
	1 90° Transite Elbow		6.21		
	1 6" Cap		4.12		
	3 hrs. Trucking @3.00		9.00		
	3 hrs. Backhoe @6.50		19.50		
	Hot Top 6' x 16'		64.02		
			335.64		
5-15-79	39' 6" Transite pipe				
	10' 4" Cast Iron pipe				


** Apply # 384 to W.H.C. # 7*

DATE _____

TOWN OF LEXINGTON — BOARD OF PUBLIC WORKS

SEWER DIVISION

Sketch of Service Here **53**

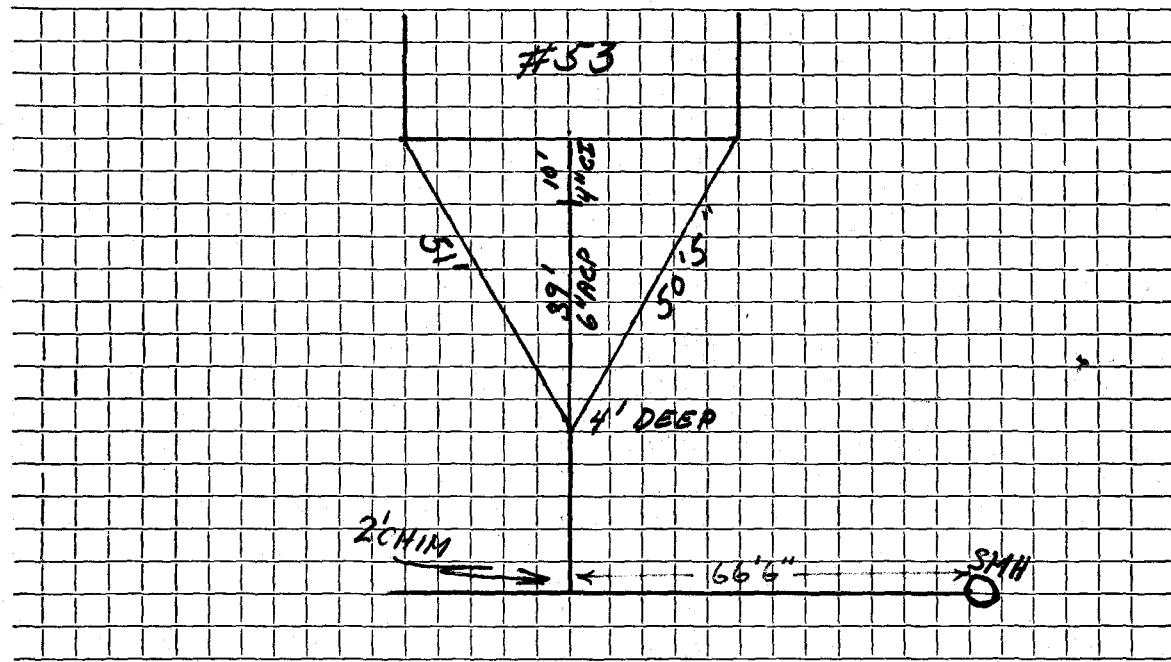

Connection made in Street. Work completed

Remarks:
.....
.....