

Name Robert Adams

Service No. 57

Address 63 Spring Street

63 Spring ST.

Location

Comm. 9/30/57

Kind of Pipe

Size 6"

Size of Main 8"

~~Repair~~ ~~Renewal~~ — New Service

Location

Date	Material	Amount	Total	Date	Amount
5/17/57	Labor	74 28		4-30-57	Deposit \$ 300 00
5/18/57	"	63 07		9-30-57	Refund \$ 23 26
		137 35			276 74
	10% overhead	13 74	151 09		
	135' - 6" Transite Pipe @ .7020		94 77		
	1 - 6" Elbow		1 88		
	4 hrs. Town Shovel @ 6.50		26 00		
	4 hrs. Trucking @ .75		3 00		
			276 74		
	Labor				* \$ 11.72 applied to W.H.C. #81

TOWN OF LEXINGTON—DEPT. OF PUBLIC WORKS
SEWER DIVISION

DATE.....

NO.


The undersigned applies for the construction of a particular sewer connecting No.....
Street and hereby agrees to comply with the Rules and Regulations governing the construction and use of Particular
Sewers, as now or at any future time established by the Board of Selectmen.

Am't of estimate \$.....

Am't Paid \$.....

..... Owner

Sketch of Service Here

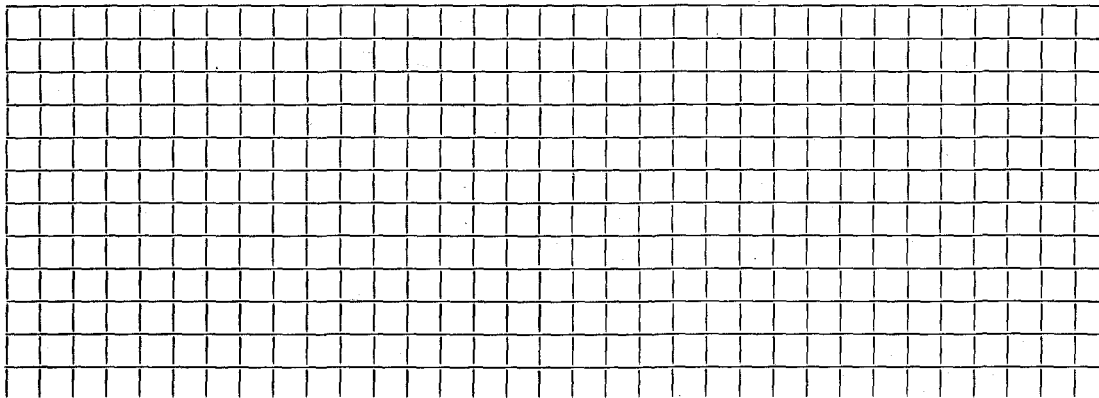

Connection made in..... Street.

Work completed.....19..

Remarks: