

Name Dianne Estates

Service No. 90

Address 67 Spring Street

67 Spring ST.

Location

Kind of Pipe

Size 6"

Size of Main 8"

Repair ~~Renewal~~ — New Service

Location Comm 11-24-58

Date	Material	Amount	Total	Date	Amount
6/13/58	labor	84 20		5-19-58	Deposit 150 00
	10% overhead	8 42		11-24-55	Paid by WHPA 90 17 14
			92 62	12-11-58	Paid
	75' 6" transite pipe @.70		52 50	12-11-58	Paid 15 34
	2 1 1/4" 6" transite elbows		4 48		182 48
	1 6' clay elbow		1 88		
	3 hrs. town shovel @ 6.50		19 50		
	2 hrs. trucking @.75		1 50		
	10x3 patch		10 00		
			182 48		
	Labor				
				Bill sent 11-24-58	15 34

TOWN OF LEXINGTON—DEPT. OF PUBLIC WORKS
SEWER DIVISION

DATE.....

NO.


The undersigned applies for the construction of a particular sewer connecting No.....
Street and hereby agrees to comply with the Rules and Regulations governing the construction and use of Particular
Sewers, as now or at any future time established by the Board of Selectmen.

Am't of estimate \$.....

Am't Paid \$.....

..... Owner

Sketch of Service Here

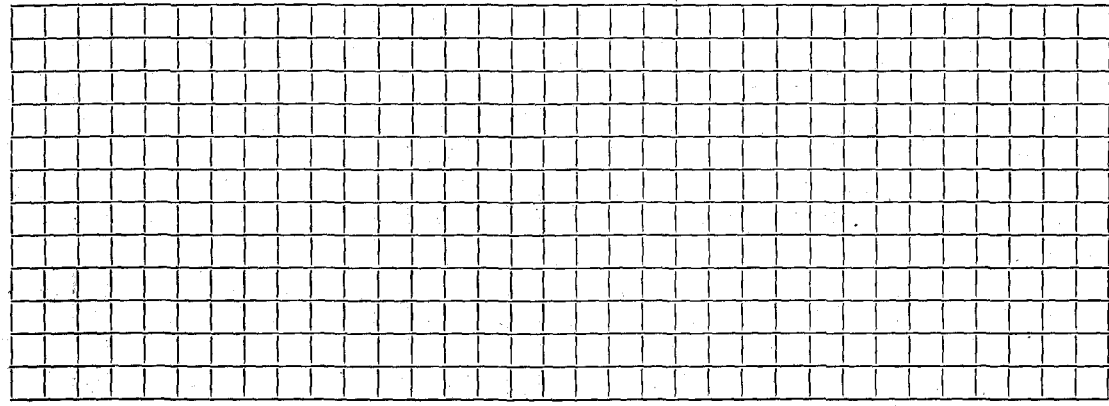

Connection made in..... Street.

Work completed.....19..

Remarks: