

Name Mrs. Russell Johnson

Service No. 176

Address 69 Spring Street

69 Spring ST.

Location

Kind of Pipe

Size 6"

Size of Main 8"

~~XXXXXXXXXXXXXXXXXXXX~~ ~~Repair - Renewal~~ - New Service W.O. #5912 Valeri Const. #884

Location


AUG 5 1968

Date	Material	Amount	Total	Date	Amount
11/29/67	Labor 68.56			11-27-67	Deposit 500 00
11/30/67	" 25.31	93 87		8-5-68	Refund 24 67
	10% O.H.	9 39	103 26		175 33
1	90° Elbow		4 09		
30'	6" Transite pipe @ .88		26 40		
½	Bag Cement @ 1.55		78		
1	Ton cold patch		5 50		
1	Ton hot top		5 80'		
3½	Hrs. Trucking @ 3.00		10 50		
2	Hrs. Shovel @ 6.50		13 00		
½	Hr. Compressor @ 5.00		2 50		
½	Hr. Roller & trailer		3 50		
			175 33		
12-8-67	81' 6" Transite pipe				
	16' 4" Cast Iron pipe				

TOWN OF LEXINGTON — BOARD OF PUBLIC WORKS

SEWER DIVISION

Sketch of Service Here **69**

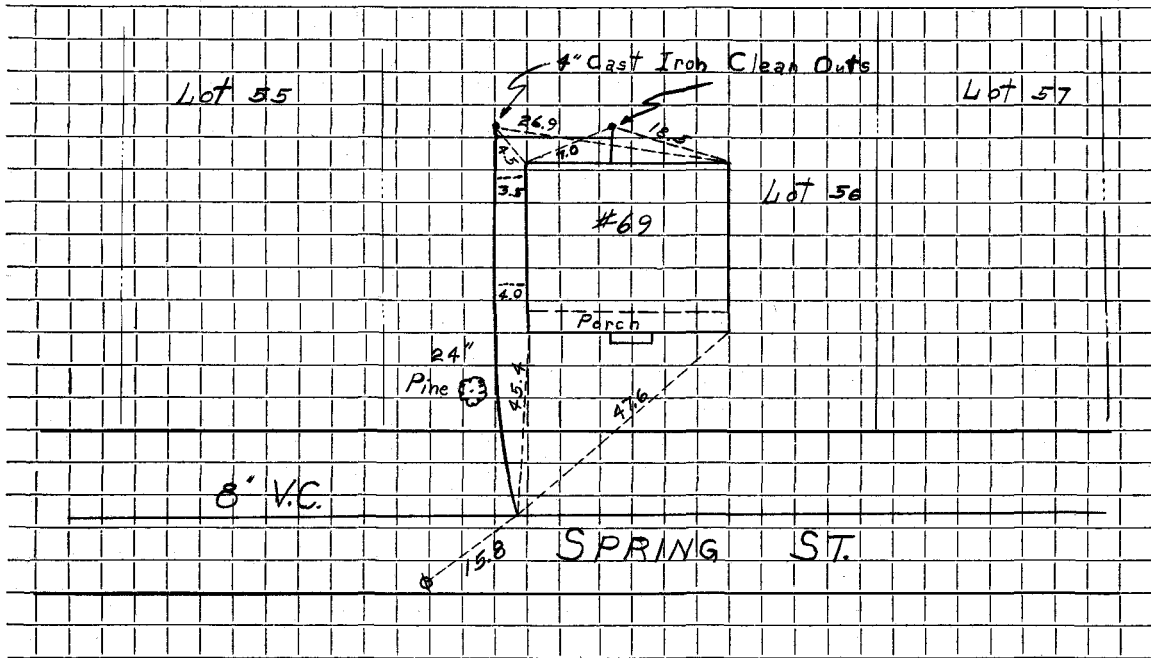

Connection made in Street. Work completed

Remarks:

.....

.....