

Name Sigward A. Fellman

Service No. 52

Address 7 Spring St.

7 Spring ST.

Location

Kind of Pipe

Size 6"

Size of Main 8"

Repair—Renewal—New Service #7056 Craftsman #1110

Location NOV 18 1968


| Date | Material | Amount | Total | Date | Amount |
|---------|----------------------|--------|--------|----------|--------|
| 8/25/68 | Labor | 62 50 | | 9-12-68 | 245 00 |
| | 10& O.H. | 6 25 | 68 75 | 11-18-68 | 126 77 |
| 20' | Transitepipe .88 | | 17 60 | | 118 23 |
| 1 | 90° Elbow | | 4 09 | | |
| 1 | 12" nipple | | 1 21 | | |
| 1/2 | Bag cement 1.55 | | 78 | | |
| 2 | Dozen btick | | 1 00 | | |
| 1 | ton hot top | | 5 80 | | |
| 2 | Hrs. shovel 6.50 | | 13 00 | | |
| 2 | " trucking 3.00 | | 6 00 | | |
| | | | 118 23 | | |
| 8-12-68 | 35' 6" Transite pipe | | | | |
| | 5' 4" Cast Iron | | | | |

DATE _____

TOWN OF LEXINGTON — BOARD OF PUBLIC WORKS

SEWER DIVISION

Sketch of Service Here **7**

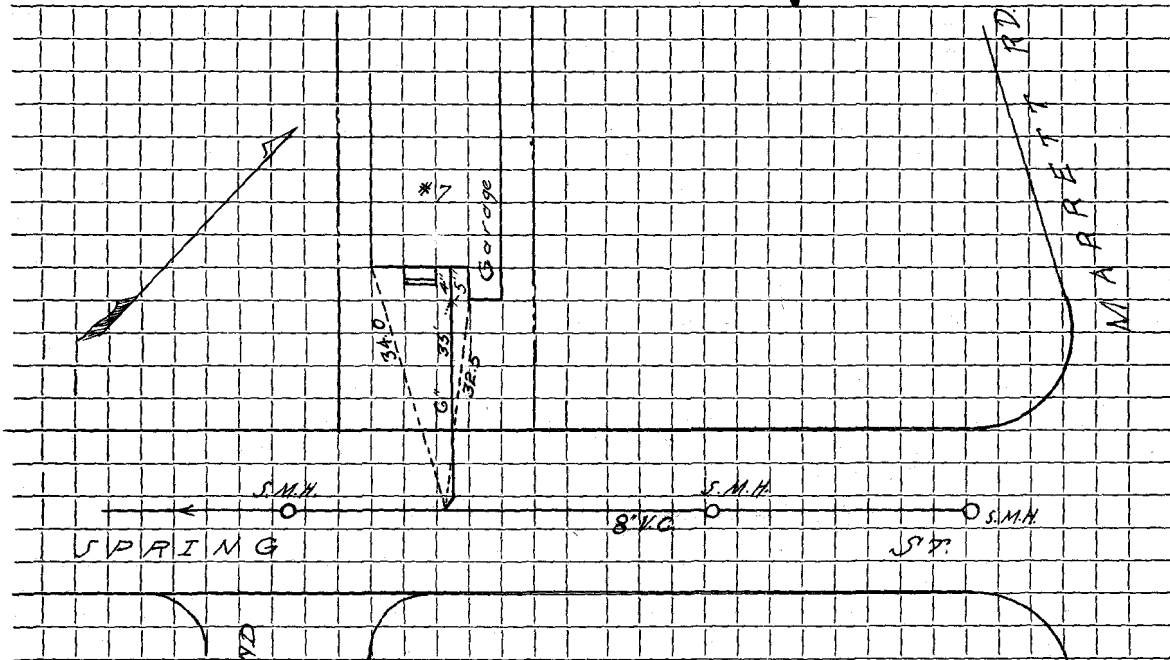

Connection made in Street. Work completed

Remarks:
.....
.....