

Name Robert Ericson

Service No. 200

Address 73 Spring Street

73 Spring ST.

Location

Kind of Pipe John Devine Permit #196

Size 6"

Size of Main 8"

Repair ~~Renewal~~ New Service W.O. #9396

Location FEB 15 1965


Date	Material	Amount	Total	Date	Amount
12-17-64	Labor	71 77		12-7-64	Deposit 150 00
	10% O.H.	7 18	78 95	2-15-65	Refund 4 26
30'	6" Transite Pipe @.82		24 60		145 74
1	900 Elbow		4 09		
1	6" Cap		1 93		
1	15 X 3 Patch		15 00		
6'	Chimney @.82		4 92		
1½	Hrs. Town Shovel @6.50		9 75		
1½	" Town Truck @3.00		4 50		
½	Hr. Loader @4.00		2 00		
			145 74		
12-23-64					
34'	6" Transite Pipe				

DATE _____

TOWN OF LEXINGTON — BOARD OF PUBLIC WORKS
SEWER DIVISION

Sketch of Service Here

73

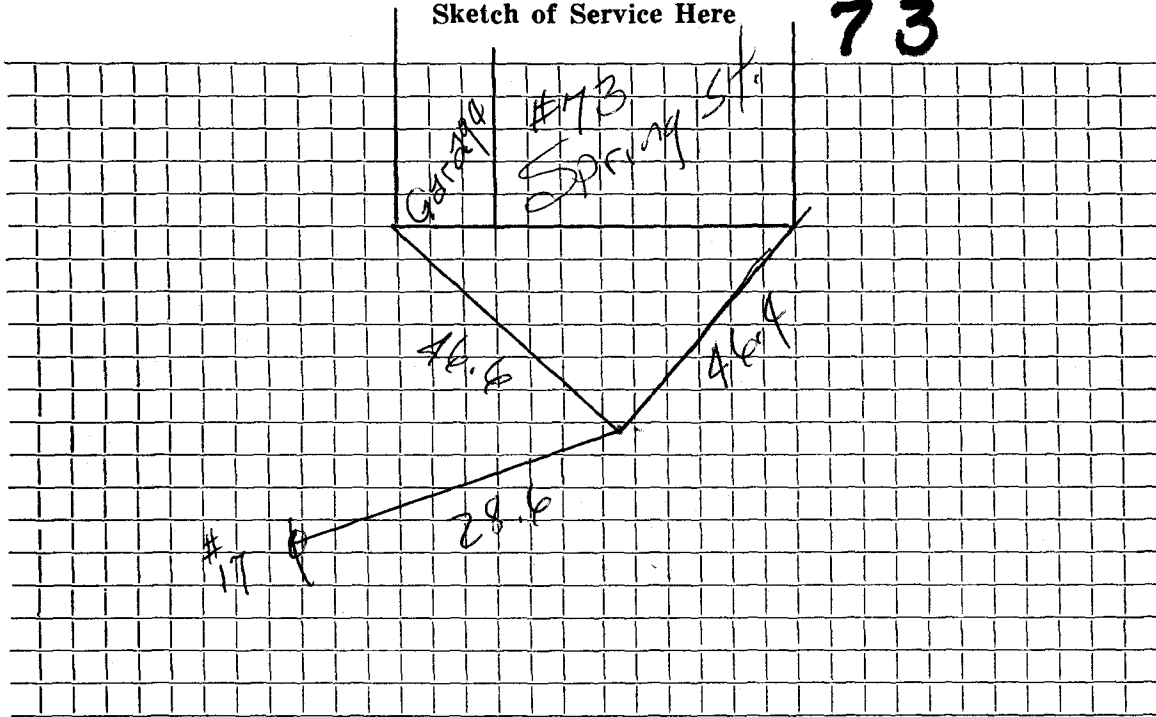

Connection made in Street. Work completed

Remarks:

.....

.....