

Name George E. Rogers

Service No. 53

Address 8 Spring Street

8 Spring ST.

Location

Kind of Pipe

Size 6"

Size of Main 8"

~~Repair/ Renewal~~ New Service W. O. # 9629

Location JUL 31 1972

Date	Material	Amount	Total	Date	Amount	
5/9/72	Labor	104 90		5-1-72	Deposit	290 00
	10% O.H.	10 49	115 39	7-31-72	Refused	96 34
	22' 6" Transite pipe .90		19 80			193 26
	1 1'-Nipple		1 71			
	1 900 Elbow		5 65			
	1 8 X 6 Saddle		15 95			
	2 6" Couplings 1.78		3 56			
	1 6" Plug		2 38			
	½ Bag cement 1.95		98			
	1 Dozen brick .07 ea.		84			
	1 Hr. Truck		1 50			
	3 Hrs. Trucking 3.00		6 00			
	3 Hrs. Shovel 6.50		19 50			
			193 26			
5/9/72	10' 4" Cast Iron					
	18' 6" Transite					


DATE _____

TOWN OF LEXINGTON — BOARD OF PUBLIC WORKS

SEWER DIVISION

Sketch of Service Here

8

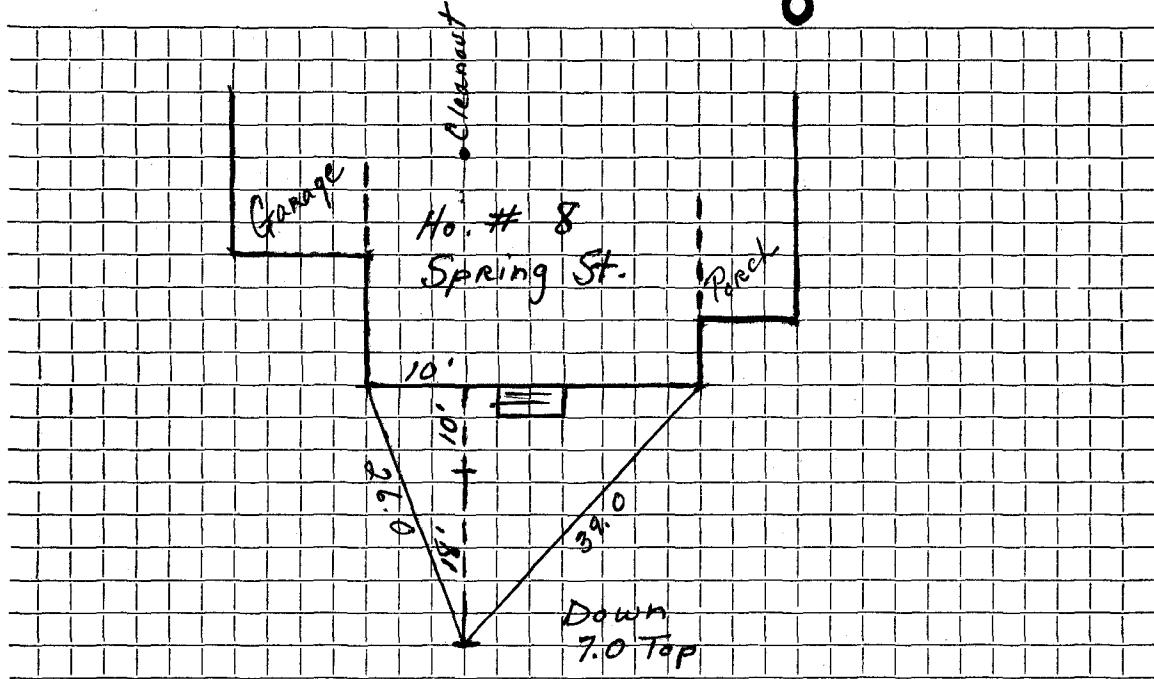

Connection made in Street. Work completed

Remarks:
.....
.....