

Name

Service No.

Address

86 Spring St

Location

Kind of Pipe

Size

Size of Main

Repair Renewal New Service

Location

Date

Material

Amount

Total

Date

Amount

9-8-04

92' - 6" PVC

10' - 4" PVC

4x6 PVC to PVC FRAMED


6x6 AC to PVC FRAMED

2 - 6" PVC 45° Bands

DATE \_\_\_\_\_

TOWN OF LEXINGTON — BOARD OF PUBLIC WORKS  
SEWER DIVISION

Sketch of Service Here

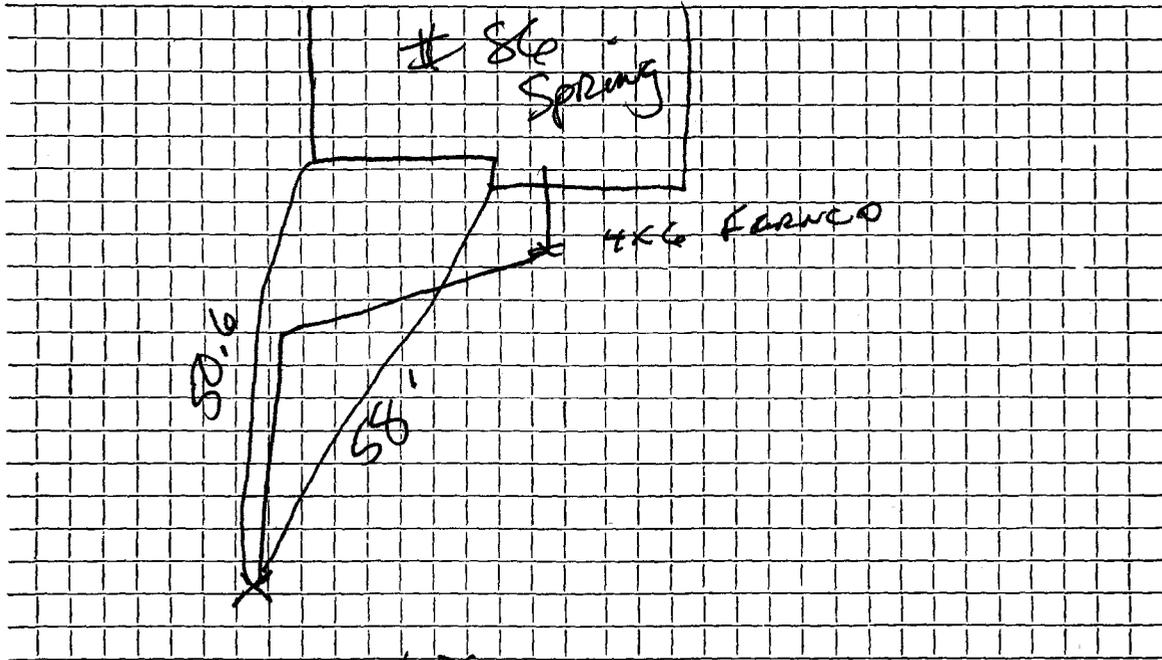

Connection made in ..... 6x6 AC to PC Forward Street. Work completed .....

Remarks: .....

.....

.....