


DATE _____

TOWN OF LEXINGTON — BOARD OF PUBLIC WORKS

SEWER DIVISION

Sketch of Service Here

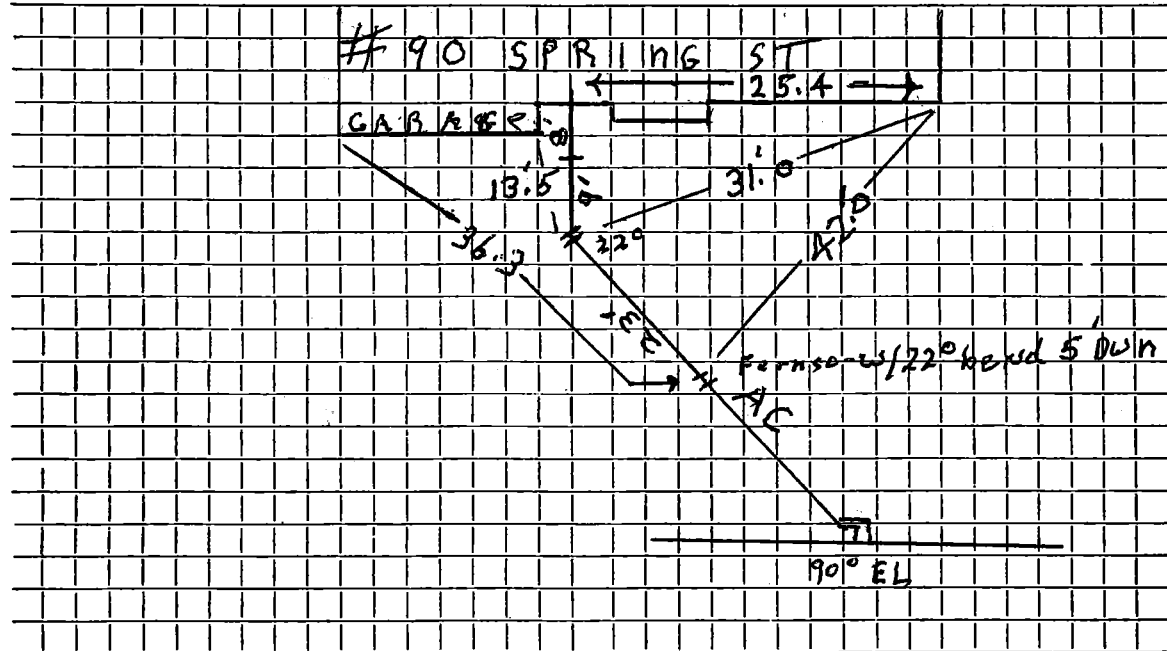

Connection made in Street.

Work completed .. 7/1/10 .. J. McIsaac g.h.s.w

Remarks:
.....
.....