

Name Irene Sobeck

Service No. 105

Address 91 Spring Street

91 Spring ST.

Location

Kind of Pipe

Size 6"

Size of Main 8"

Repair—Renewal—New Service W.O.#5382 Bonnano #804

Location MAR 18 1968

Date	Material	Amount	Total	Date	Amount
9-18-67	43' 6" Transite pipe			8-28-67	125 00
	10' 4" Cast Iron pipe			3-18-68	12 90
				3/14/69	42 16
3/28/67	Labor 81.10				180 06
3/26/67	Labor 20.43	101 53			
	10% O.H.	10 15	111 68		
	23' 6" Transite pipe @ .88		20 24		
	1/4 Bag Cement @ 1.55		39		
	Brick & sand		95		
	1 Ton cold patch		5 00		
	3 Hr. Trucking @ 3.00		9 00		
	3 Hrs. Shovel @ 6.50		19 50		
	1 1/2 Hr. Loader @ 4.00		6 00		
	1/2 Roller @ 3.00		1 50		
			180 06		

Deposit
Paid by W.O.#56
Paid


Bill 42 16

DATE _____

TOWN OF LEXINGTON — BOARD OF PUBLIC WORKS
SEWER DIVISION

Sketch of Service Here **91**

LOT 15

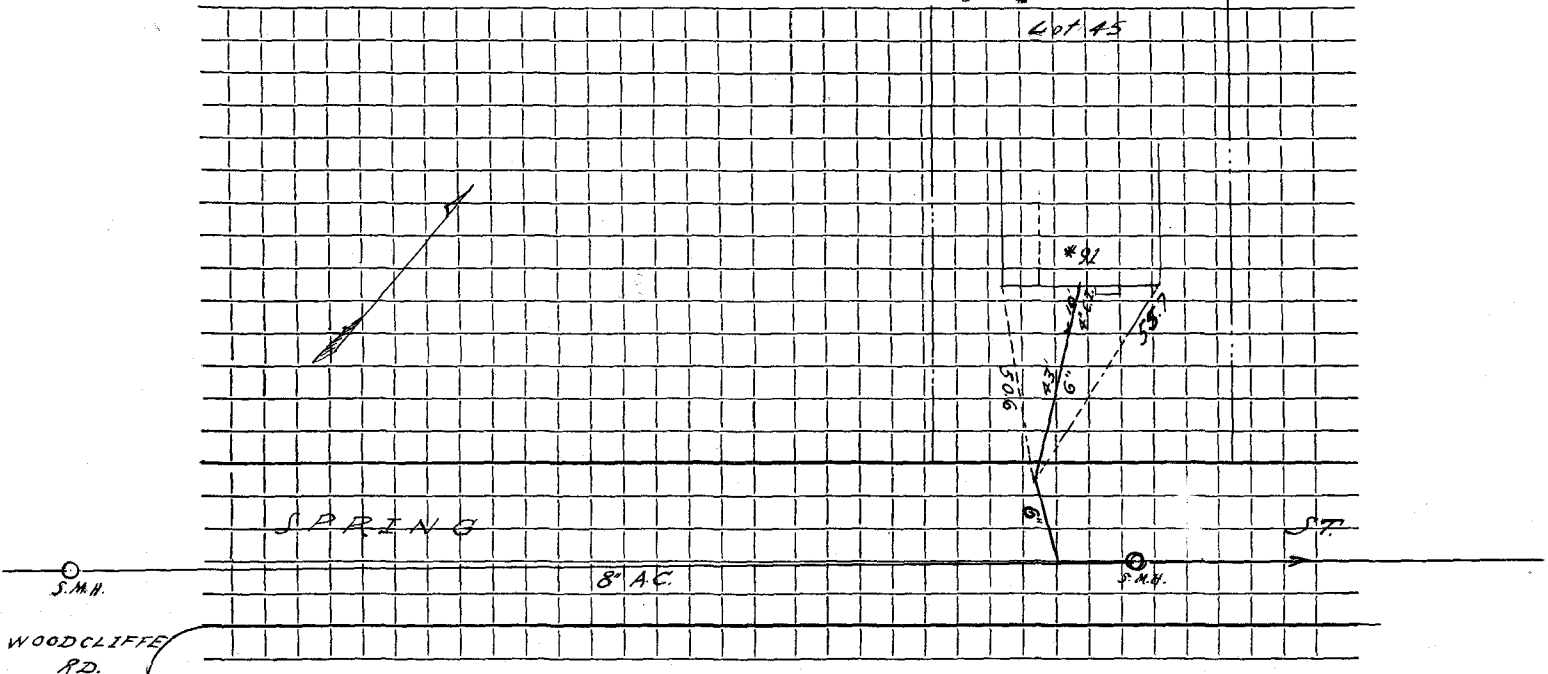

Connection made in Street. Work completed

Remarks:
.....
.....