

Name Guy D. BusaService No. 116Address 94 Spring Street94 Spring ST.

Location

Kind of Pipe

Size 6"Size of Main 8"Repair—Renewal—New Service DeFlice Bros. #1770
W.O. #9132Location DEC 31 1970


Date	Material	Amount	Total	Date	Amount
11/2/70	Labor	20.00		10-30-70	100.00
	10% O.H.	2.00	22.00		
	20' 6" Transite pipe @.90		18.00		
	2 ton Cold Patch @6.00		12.00		
	3 ton Hot Top @6.00		18.00		
	3 hrs. Trucking @3.00		9.00		
	3 hrs. Town Shovel @6.50		19.50		
	1/2 hr. Roller @3.00		1.50		
			100.00		
1-9-70	27' 6" Transite pipe				
	10' 4" Cast Iron pipe				

DATE _____

TOWN OF LEXINGTON — BOARD OF PUBLIC WORKS

SEWER DIVISION

Sketch of Service Here **94**

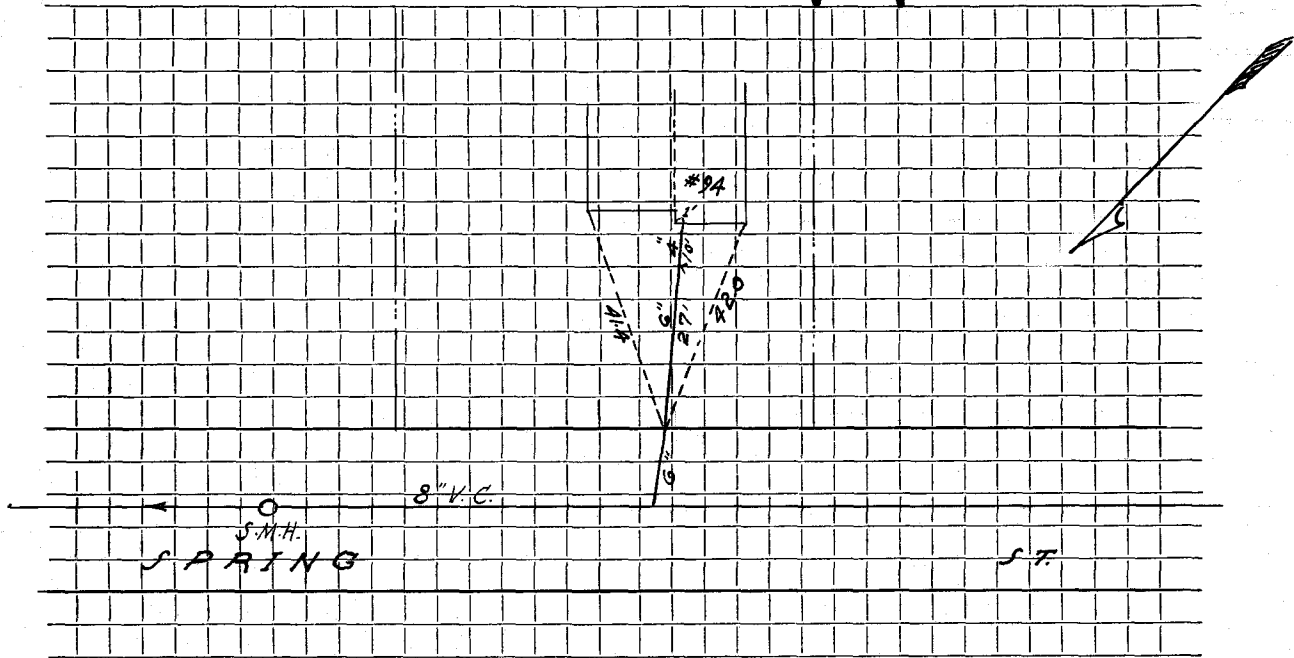

Connection made in Street. Work completed

Remarks:
.....
.....