


DATE _____

TOWN OF LEXINGTON — BOARD OF PUBLIC WORKS
SEWER DIVISION

Sketch of Service Here **98**

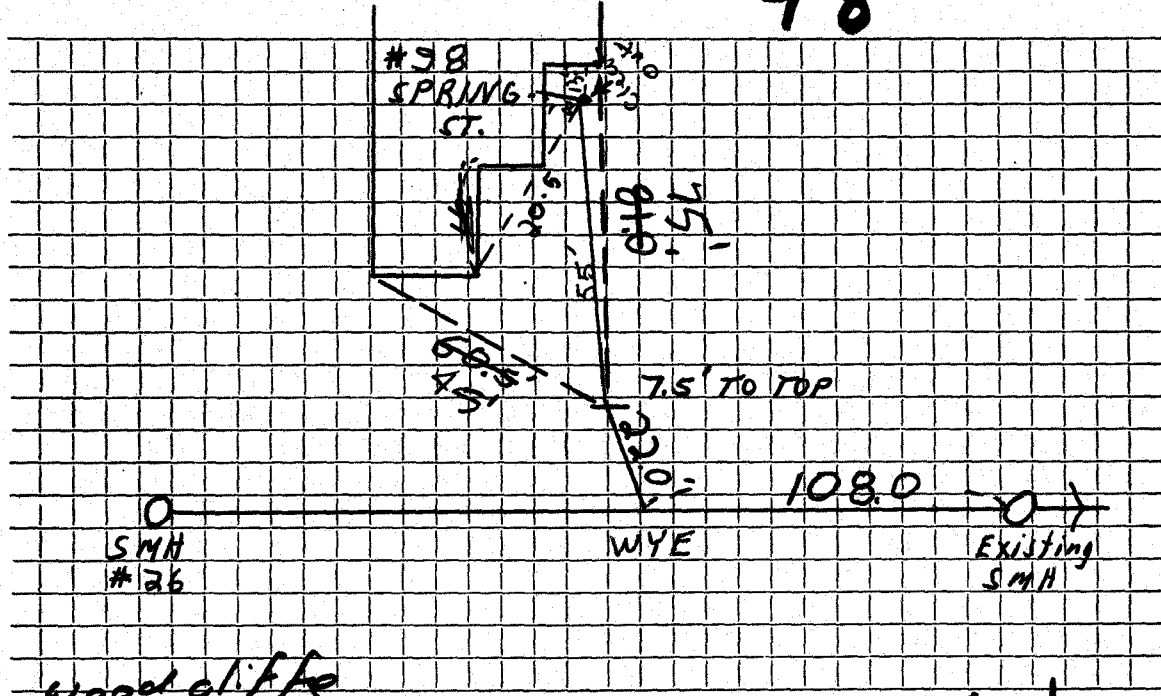

Connection made in Woodcliffe ~~Woodcliff~~ Street.

Work completed 9/9/75

Remarks:

.....

.....