


DATE 3-23-98

TOWN OF LEXINGTON — BOARD OF PUBLIC WORKS
SEWER DIVISION

Sketch of Service Here

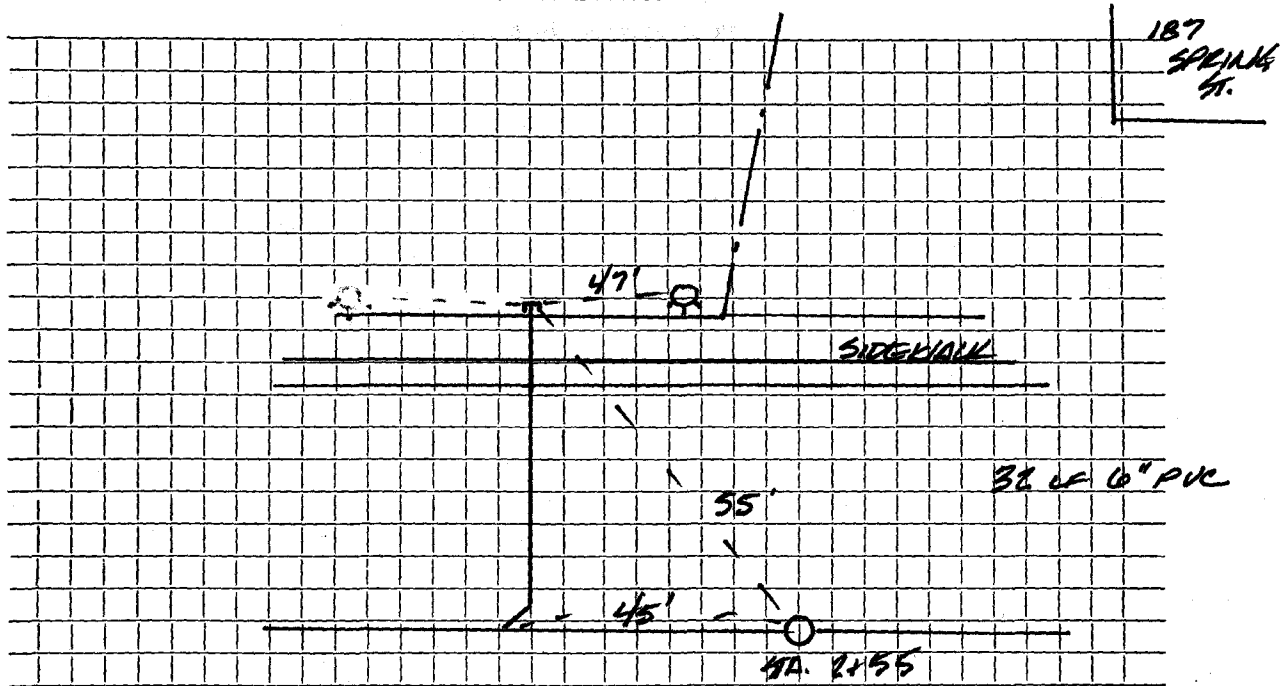

Connection made in SPRING Street.

Work completed CONTRACT 97-4

Remarks:
.....
.....