


DATE _____

TOWN OF LEXINGTON — BOARD OF PUBLIC WORKS
SEWER DIVISION

Sketch of Service Here **11**

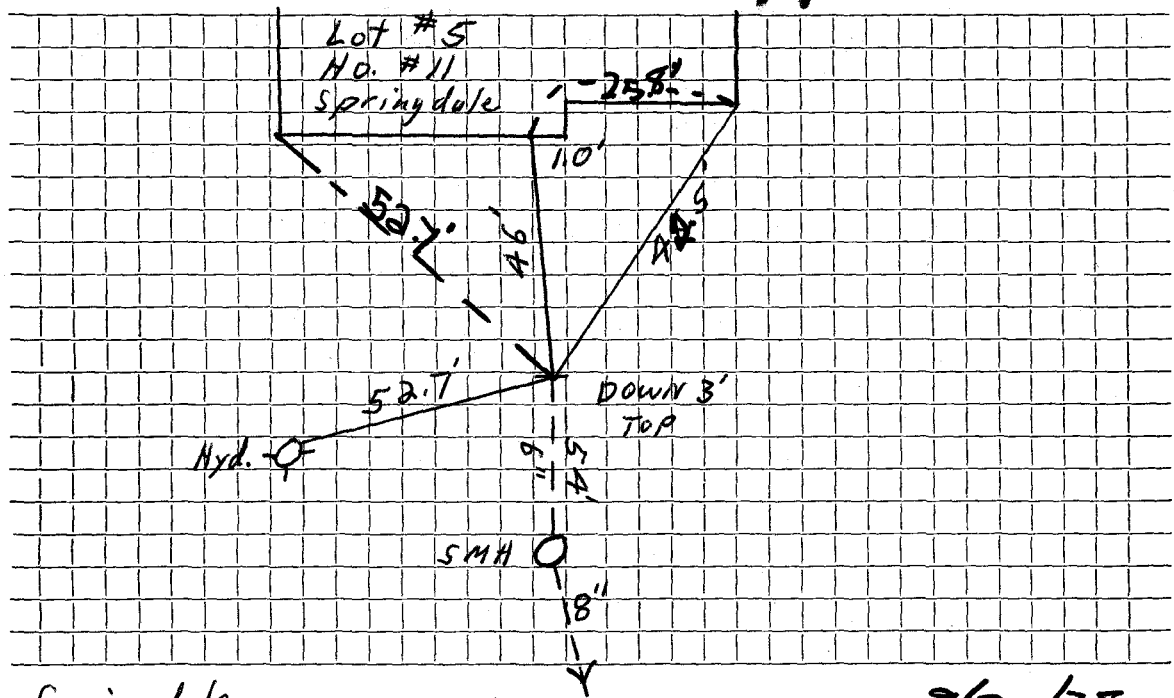

Connection made in Springdale Street. Work completed 9/30/75

Remarks:

.....

.....