

Name

Service No.

Address *12 Springdale Road*

*Lot # 7*

Location

Kind of Pipe

Size *6"*

Size of Main *8"*

Repair—Renewal—New Service *Malone # 2473 Kirkland #2527*

Location

Date		Material	Amount		Total		Date		Amount	
<i>4/2/74</i>	<i>26'</i>	<i>6" Transite</i>								
<i>10/2/74</i>	<i>50'</i>	<i>6" Transite pipe</i>								
	<i>10'</i>	<i>4" Cast Iron pipe</i>								


DATE \_\_\_\_\_

TOWN OF LEXINGTON — BOARD OF PUBLIC WORKS

SEWER DIVISION

Sketch of Service Here

12

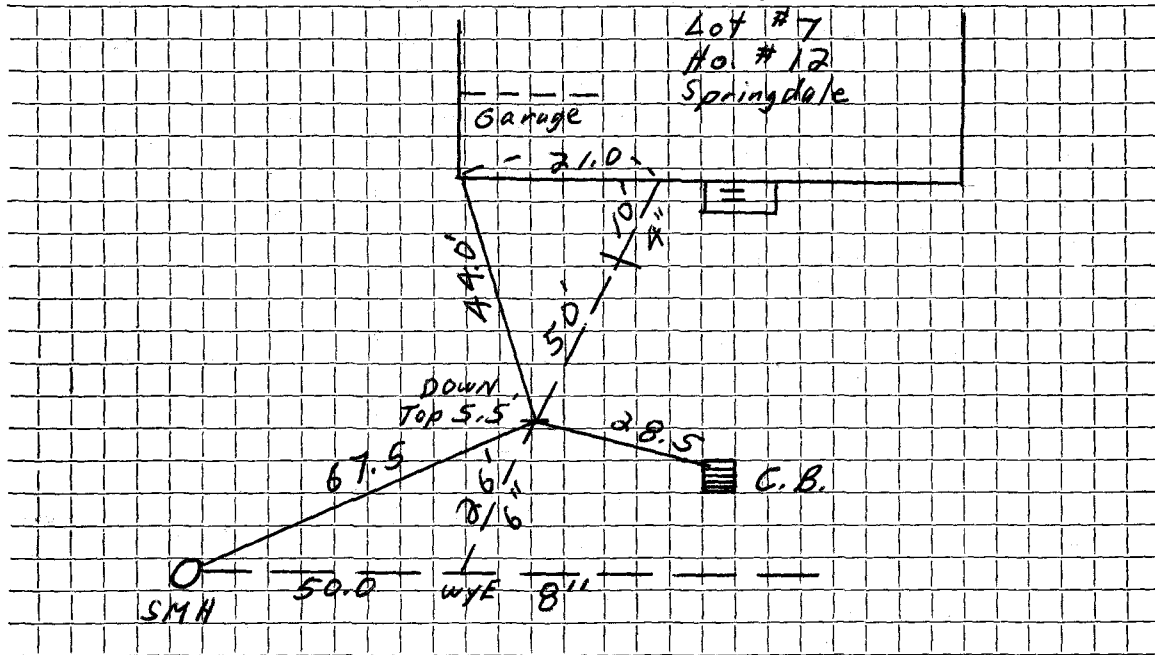

Connection made in Springdale Street. Work completed .....

Remarks: .....

.....

.....