

Name Jenkins Realty

Service No.

Address 14 Springdale Road

Lot # 6

Location

Kind of Pipe

Size 6"

Size of Main 8"

Repair—Renewal—New Service Malone #2474


Location

Date		Material	Amount	Total	Date	Amount
4/2/74	53'	6" Transite				
9/30/75	34'	6" Transite Pipe				
	10'	4" Cast Iron Pipe				

DATE _____

TOWN OF LEXINGTON — BOARD OF PUBLIC WORKS
SEWER DIVISION

Sketch of Service Here **14**

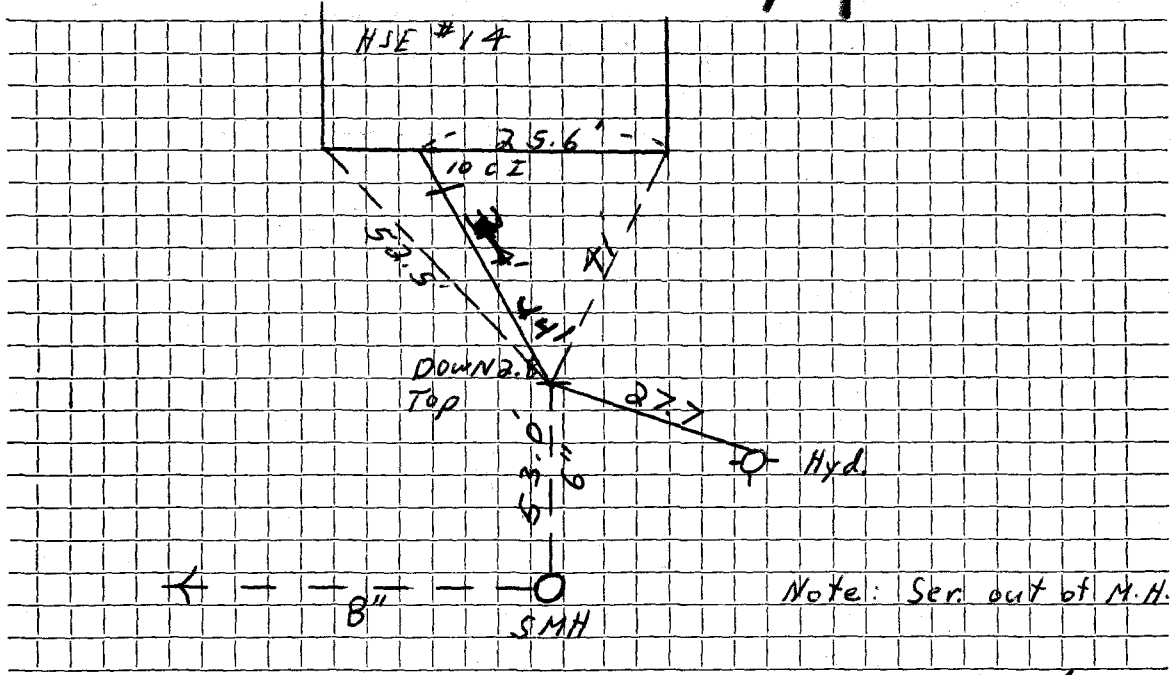

Connection made in Springdale Road Street. Work completed 9/30/75

Remarks:

.....

.....