

Name Joe Maggiore

Service No.

Address 2 Springdale Road

Lot # 12

Location

Kind of Pipe

Size

Size of Main


Repair—Renewal—New Service Malone #2464

Location

Date		Material	Amount	Total	Date		Amount
4/2/74	26"	6" Transite					
2/24/75	25'	8" Transite Pipe					
	78'	4" Cast Iron Pipe					

TOWN OF LEXINGTON — BOARD OF PUBLIC WORKS

SEWER DIVISION

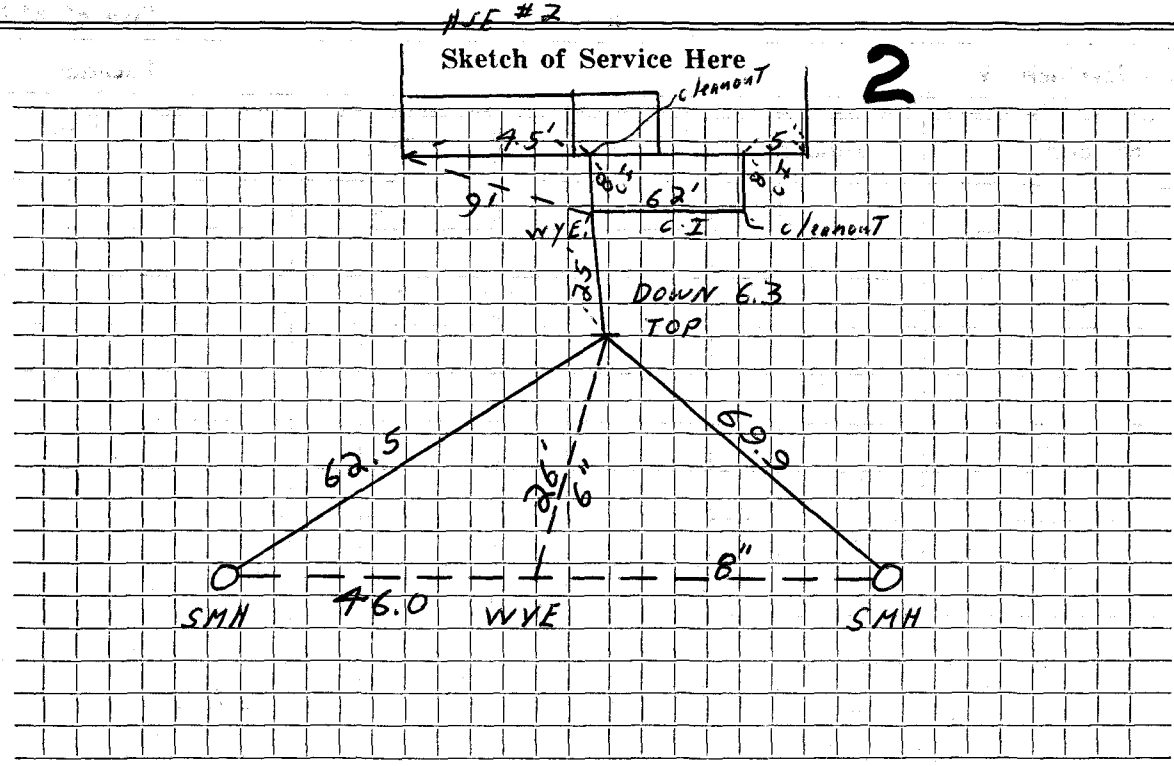

Connection made in *Springdale... R.C.P.* Street. Work completed ... ~~At~~ .....

Remarks: .....

.....

.....