

Name

Service No.

Address

7 Springdale Road

Lot # 3

Location

Kind of Pipe

Size 6"

Size of Main 8"

Repair—Renewal—New Service

Malone # 2467

Location

Date

Material

Amount

Total

Date

Amount

4/2/74 26'

6" Transite


DATE _____

TOWN OF LEXINGTON — BOARD OF PUBLIC WORKS

SEWER DIVISION

Sketch of Service Here

7

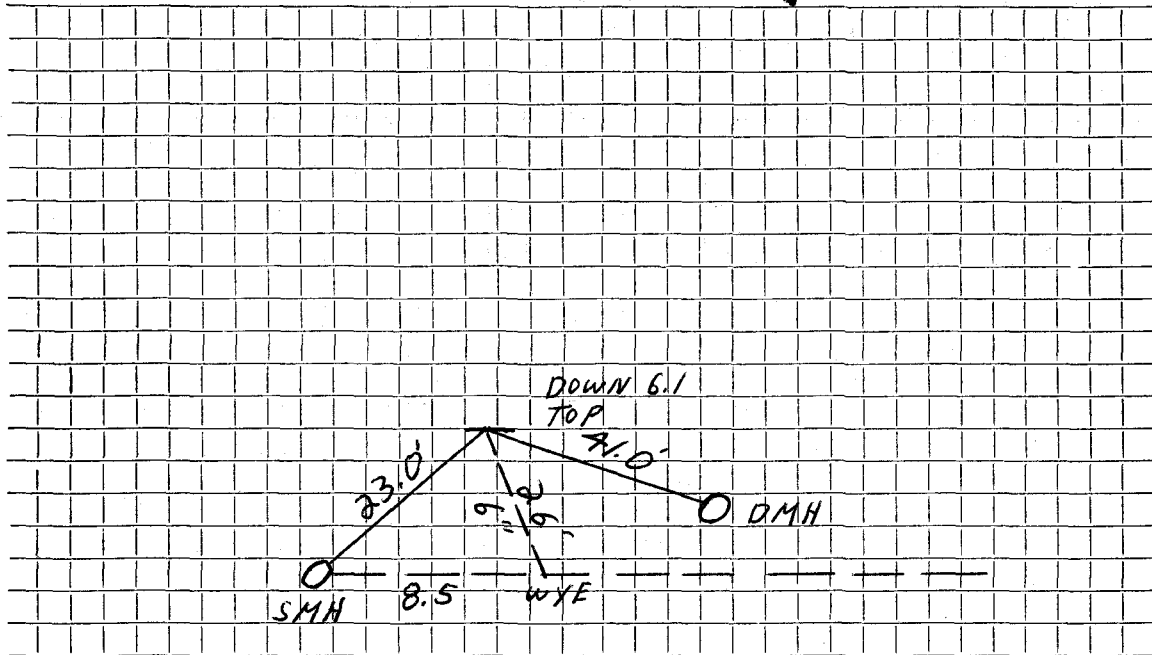

Connection made in Springdale Street. Work completed

Remarks:
.....
.....