

Name Mr. L. C. Thompson

Service No. 37 253

Address 34 Springfield St., Watertown # 20 ?

Location Forest Street (Double House)

Kind of Pipe Size Size of Main

Requirements - New Service

Location

Date	Material	Amount	Total	Date	Amount
5/4/28	55' 6" Clay Pipe @ .30	16 50			
	1 6" x 1/8" Bend	70			
	Sulphur & Jute	2 20	19 40	Nov. 30 1928 - Cash	19 40
	Time on water slip				
	Laber				

TOWN OF LEXINGTON—BOARD OF PUBLIC WORKS
SEWER DIVISION

DATE _____

NO. _____


The undersigned applies for the construction of a particular sewer connecting No. _____ Street and hereby agrees to comply with the Rules and Regulations governing the construction and use of Particular Sewers, as now or at any future time established by the Board of Selectmen.

Am't. of Estimate \$ _____

Am't. Paid \$ _____

_____ Owner

Sketch of Service Here

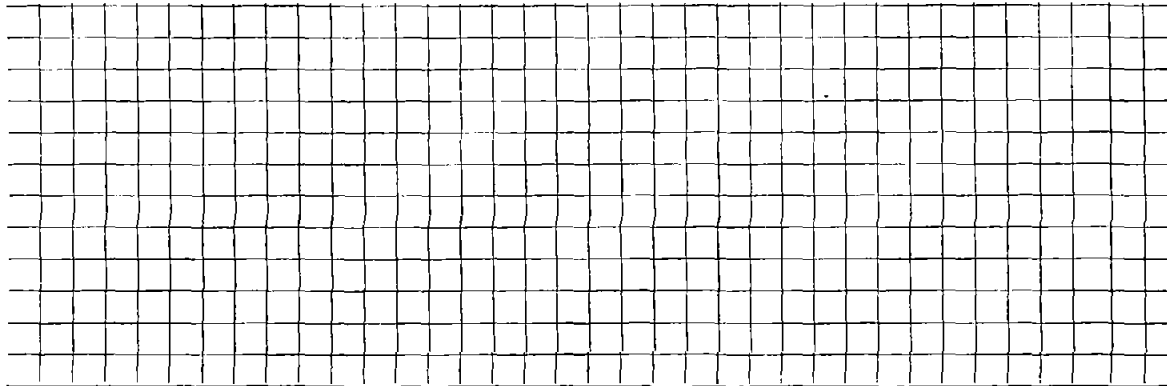

Connection made in _____ Street.

Work completed _____ 19

Remarks: