


DATE 4/19/90
P.A.B.

TOWN OF LEXINGTON — BOARD OF PUBLIC WORKS

SEWER DIVISION

Sketch of Service Here

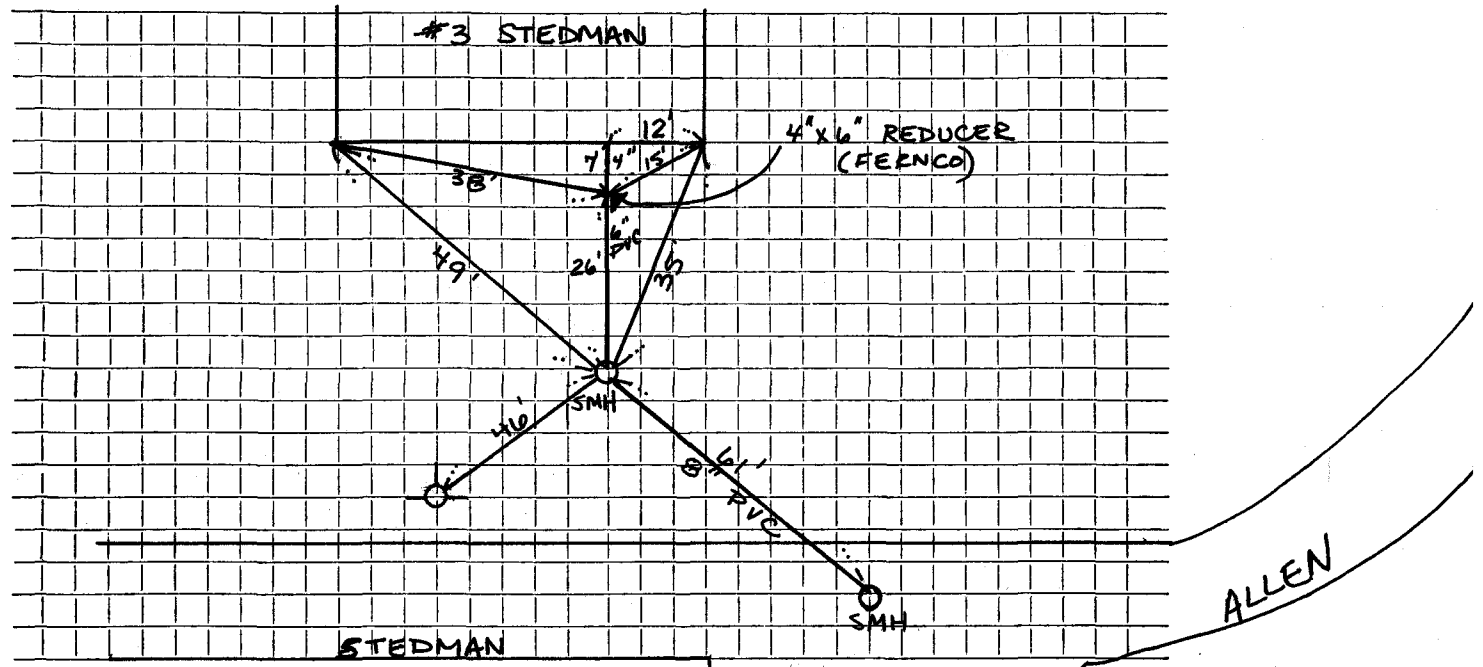

Connection made in ... STEDMAN ... Rd. Street. Work completed

Remarks: INSPECTED: P.A. BARRONS

..... CONTRACTOR: ARLEX