




DATE 8-21-78

TOWN OF LEXINGTON — BOARD OF PUBLIC WORKS  
SEWER DIVISION

Sketch of Service Here

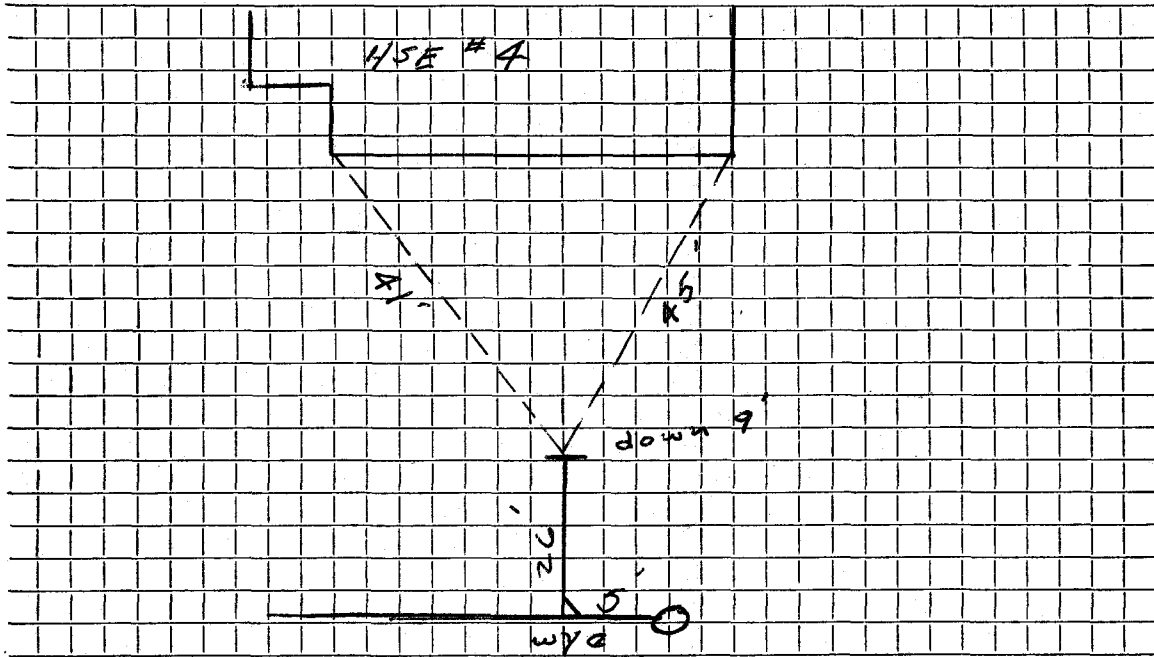

Connection made in Stodman Rd. Street. Work completed .....

Remarks: .....  
.....  
.....