

Name

Service No.

Address

Franklin School

#7
(Stedman Rd.)

7 Stedman Road

Location

Kind of Pipe

Size 6"

Size of Main 8"

Repair—Renewal—New Service


Location

| Date | Material | Amount | Total | Date | Amount |
|---------|-------------------------|--------|--------|------|--------|
| 9-25-78 | 14 Lf of 6" ACP @ 16.53 | = | 231.42 | | |
| | | | | | |
| | | | | | |
DATE _____

TOWN OF LEXINGTON — BOARD OF PUBLIC WORKS
SEWER DIVISION

Sketch of Service Here

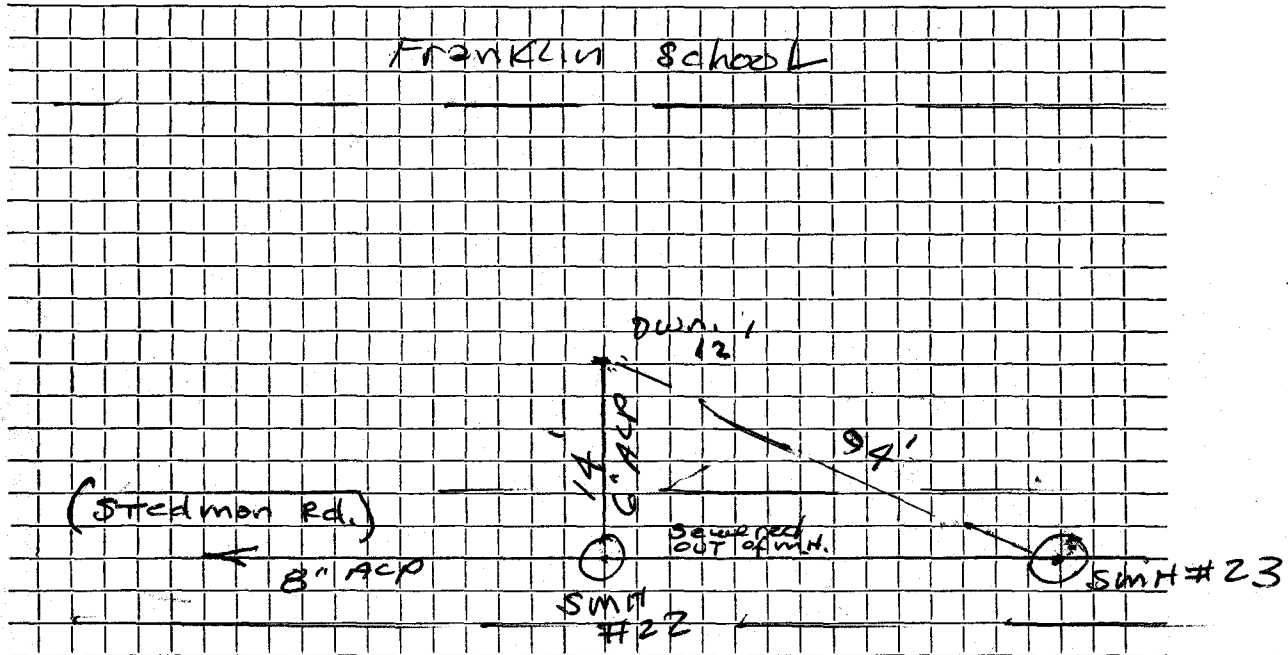

Connection made in Street. Work completed

Remarks:

.....

.....