

Name

Service No.

Address

VACANT LOT STEDMAN RD.

Location

Kind of Pipe

AC

Size

6"

Size of Main

8"

Repair—Renewal—New Service

Location

Date

Material

Amount

Total

Date

Amount

8-7-70

20' of 6" ACP @

~~13~~ 16.53


=

330.60

DATE _____

TOWN OF LEXINGTON — BOARD OF PUBLIC WORKS
SEWER DIVISION

Sketch of Service Here

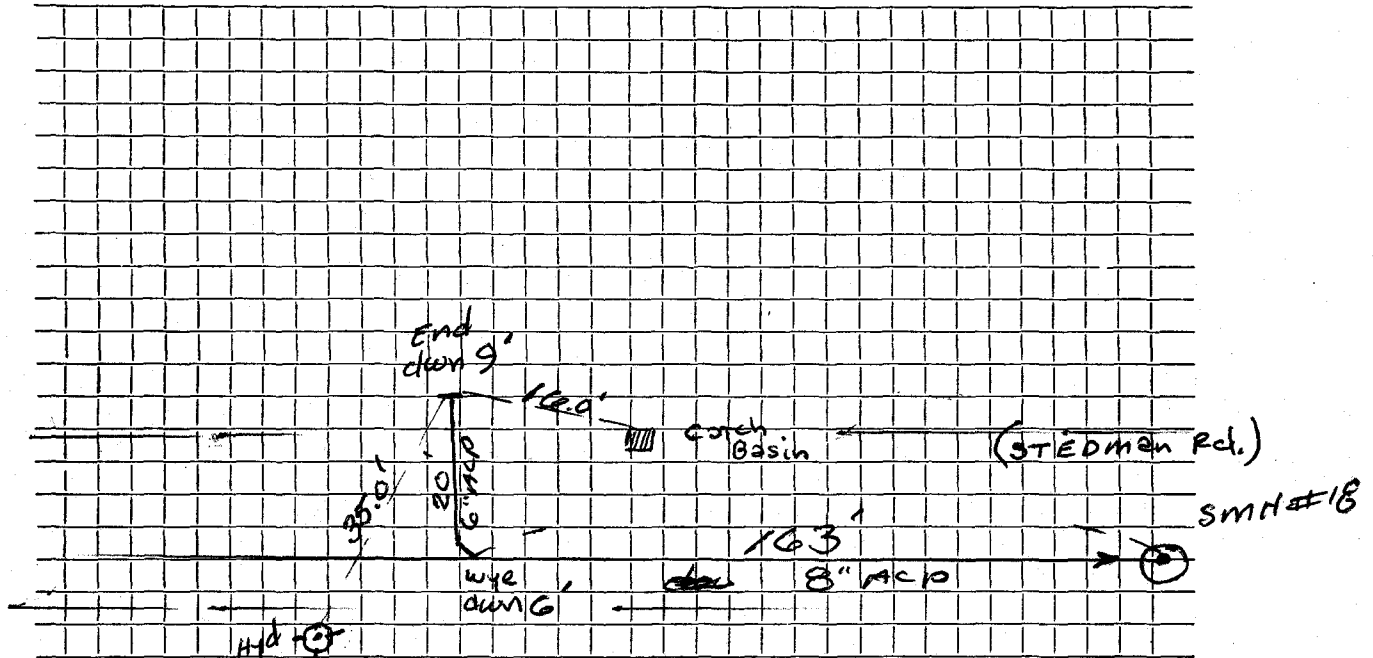

Connection made in STEDMAN Rd Street. Work completed

Remarks:
.....
.....