

Name Winfield S. Couette

Service No. 91

Address #1 STEARNS ROAD

1 STearns Road

Location

Kind of Pipe

Size 6"

Size of Main 8"

~~Repair/ Renewal~~ New Service WO# 9390


Location Cam 10-1-62

Date	Material	Amount	Total	Date	Amount
6-28-62	Labor 46.76			6-21-62	Deposit 250.00
6-29-62	" 24.51	71.27		10-1-62	Refund 69.81
	10% O.H.	7.13	78.40		180.19
	65' 6" Transite pipe @.78		50.70		
	1 90° Transite Elbow		4.09		
	4 hrs. Town Shovel @6.50		26.00		
	3 hrs. Trucking @3.00		9.00		
	12 x 3 Patch		12.00		
			180.19		

DATE _____

TOWN OF LEXINGTON — BOARD OF PUBLIC WORKS
SEWER DIVISION

Sketch of Service Here

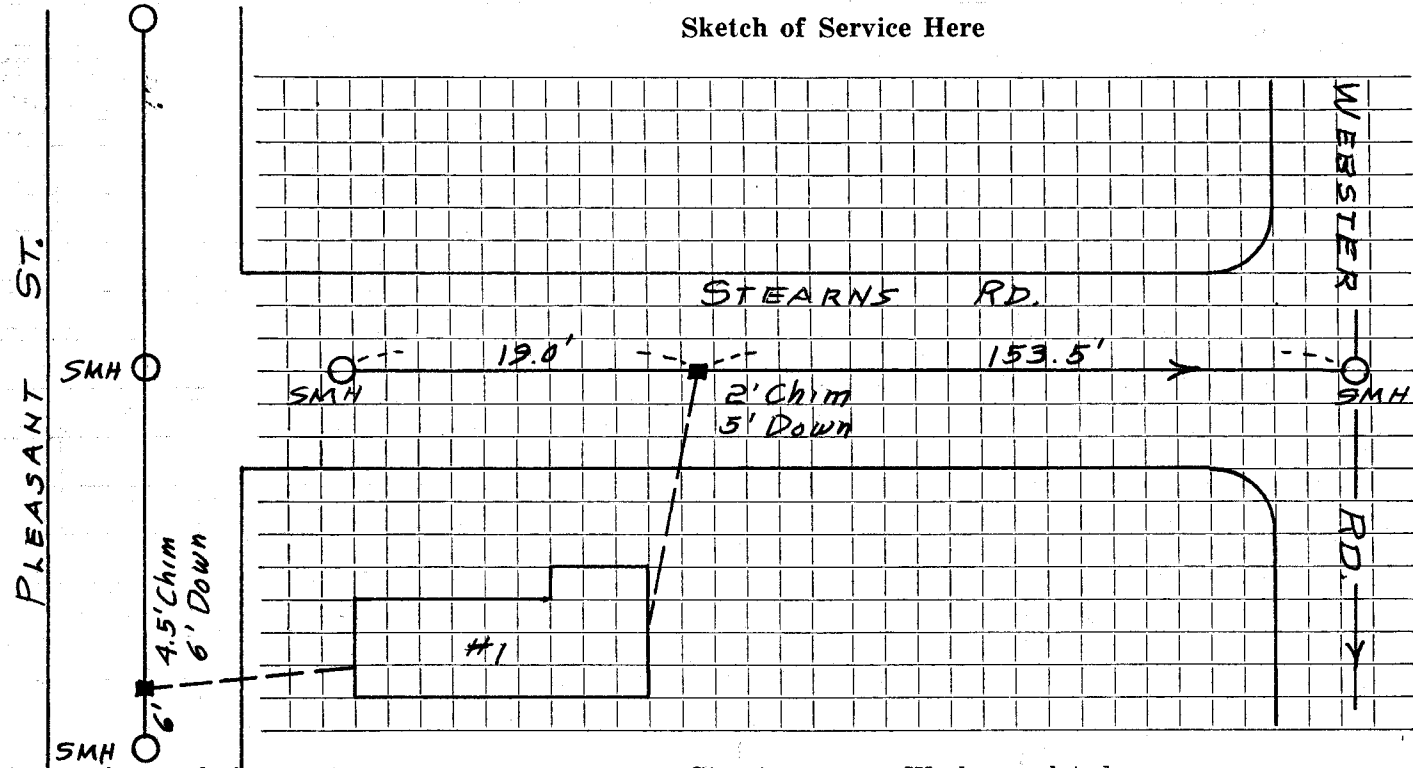

Connection made in Street. Work completed

Remarks:
.....
.....