

Name ~~Builder~~: Merle Miller, Mt. Vernon St., Malden,

Service No. ~~14~~ 925

Address ~~Owner~~: Marion Brown, 19 Oakland Street

4 Stetson St. Location 4 Stetson St.,

Kind of Pipe Size 6" Size of Main 8"

Repair—Renewal—New Service Location

Date 1939	Material	Amount	Total	Date	Amount
Sept. 12	96½ hrs. @ 55¢	53 08		August 23, 1939	125 00
<i>Cont</i> 10/30/39	26½ " @ 60¢	15 90		December 12, 1939	35 84
	8 " @ 65¢	5 20	74 18 ✓		160 84
	10% Overhead		7 41 ✓		
	48' 6" Sewer Pipe @ 15¢		7 20 ✓		
	1 6" 1/8 Bend		62		
	Jointing compound		2 88 ✓		
	Compressor 6½ hrs. @ 3.00		19 50		
	Trucking 8 hrs. @ 75¢		6 00 ✓	11/3/39	Bell sent 31.84
	13 sticks dynamite @ 25¢		3 25		
	10 blasting caps @ 08¢		80		
			121 84		
	Trench repair charges		39 00 ✓		
	Labor		160 84		

Hadley Press, Inc., Lexington

TOWN OF LEXINGTON—BOARD OF PUBLIC WORKS

SEWER DIVISION

DATE Aug 22 1939

NO. 4<sup>2</sup> Station St.

The undersigned applies for the construction of a particular sewer connecting No. Station St. Street and hereby agrees to comply with the Rules and Regulations governing the construction and use of Particular Sewers, as now or at any future time established by the Board of Selectmen.


Am't. of Estimate \$ 175<sup>00</sup>

Am't. Paid \$ \_\_\_\_\_

Builder Merle Miller - Owner

Marion Brown Owner

Sketch of Service Here

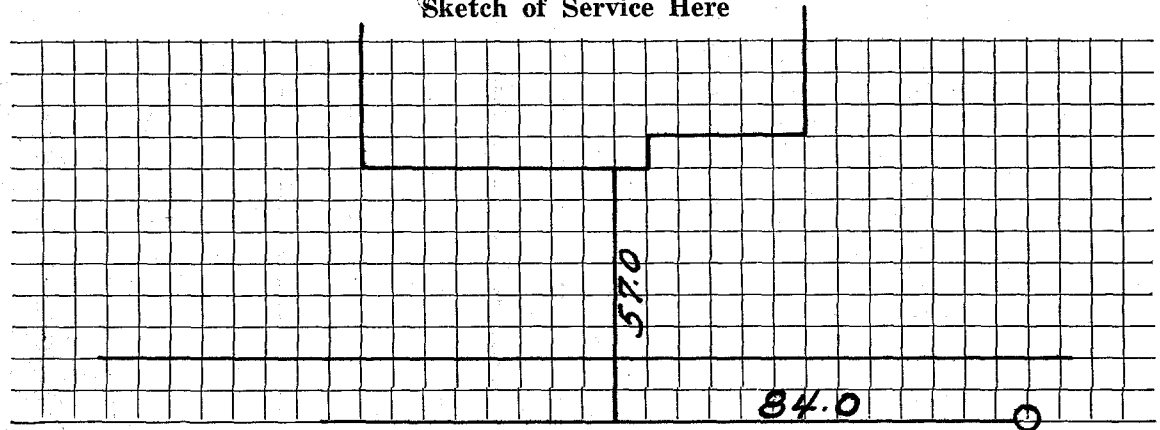

Connection made in \_\_\_\_\_ Street.

Work completed \_\_\_\_\_ 19

Remarks: