

Name Allen J. MacGilvray

Service No. 17 130

Address 12 ~~Gary Street~~ <sup>Stevens Rd</sup>, Lexington, Mass.

12 Stevens Road

Location

Kind of Pipe

Size 6"

Size of Main 8"

~~REPAIR~~ ~~RENEWAL~~ - New Service

Location

Date 1942	Material	Amount	Total	Date	Amount
Sept. 18, 1942	2 hrs. @ 55¢	1 10		August 27, 1942	45.00
<del>Sept 19/42</del>	30 " @ 60¢	18 00		October 14, 1942	1.05
	9 " @ 65¢	5 85		Refund	
	6 " @ 75¢	4 55	29 50		43 95
	10% Overhead		2 95		
	20' 6" Sewer Pipe @ 16¢		3 20		
	10' 4" Soil Pipe @ 50¢		5 00		
	1 1/8 6" Bend		60		
	Jointing compound		1 20		
	2 hrs. trucking @ 75¢		1 50		
			43 95		
	Labor				

Hadley Press, Inc., Lexington

TOWN OF LEXINGTON—BOARD OF PUBLIC WORKS  
SEWER DIVISION

DATE \_\_\_\_\_

NO. \_\_\_\_\_


The undersigned applies for the construction of a particular sewer connecting No. 12 Cary St Street and hereby agrees to comply with the Rules and Regulations governing the construction and use of Particular Sewers, as now or at any future time established by the Board of Selectmen.

Am't. of Estimate \$ \_\_\_\_\_

Am't. Paid \$ \_\_\_\_\_

Allen J Mac Silvey Owner

Sketch of Service Here **12**

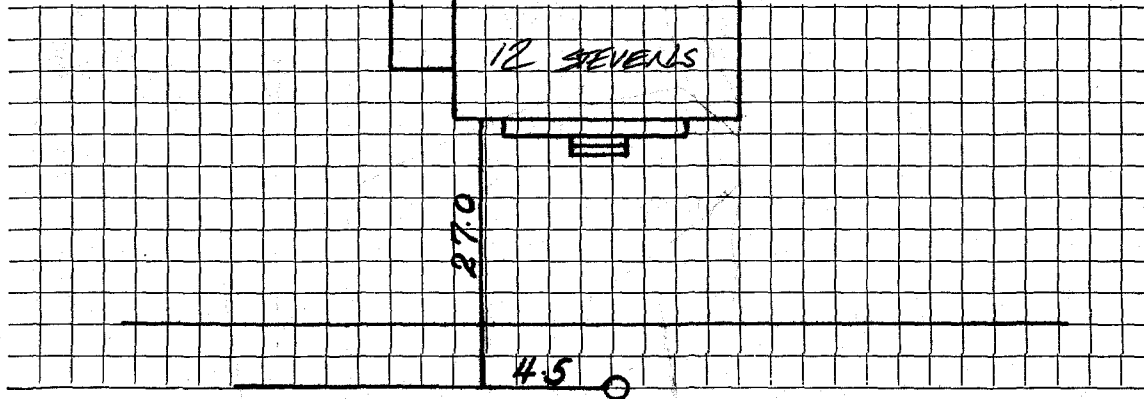

Connection made in \_\_\_\_\_ Street.

Work completed \_\_\_\_\_ 19

Remarks: