

Name Harry E. Johnson

Service No. 22 123

Address ~~50 Brighton Street, Belmont.~~

2 Stevens Rd.

Location

Lot #33 ~~Cambridge Street~~

Stevens Rd

Kind of Pipe

Size 6"

Size of Main 8"

~~Repair-Renewal~~ - New Service

Location

Date 1936	Material	Amount	Total	Date	Amount
Nov. 20	22 hrs. @ 60¢	13 20		Oct 30, 1936 Deposited	32 50
Com 2-16-37	10% overhead	1 32	14 52	Feb 25, 1937 Refunded	7 63
38'	6" Sewer Pipe @ 20¢		7 60	(credited 3.65 to Water Con # 45)	
	Joint. Comp.		2 00		
	Trucking		75		
			24 87		\$ 24 87
	Labor				

Hadley Press, Inc., Lexington

TOWN OF LEXINGTON—BOARD OF PUBLIC WORKS

SEWER DIVISION

DATE October 28, 1936

Lot # 21 NO. July

The undersigned applies for the construction of a particular sewer connecting No. 21 July Street and hereby agrees to comply with the Rules and Regulations governing the construction and use of Particular Sewers, as now or at any future time established by the Board of Selectmen.


Am't. of Estimate \$ _____

Am't. Paid \$ _____

Henry Johnson Owner

2 STEVENS

Sketch of Service Here

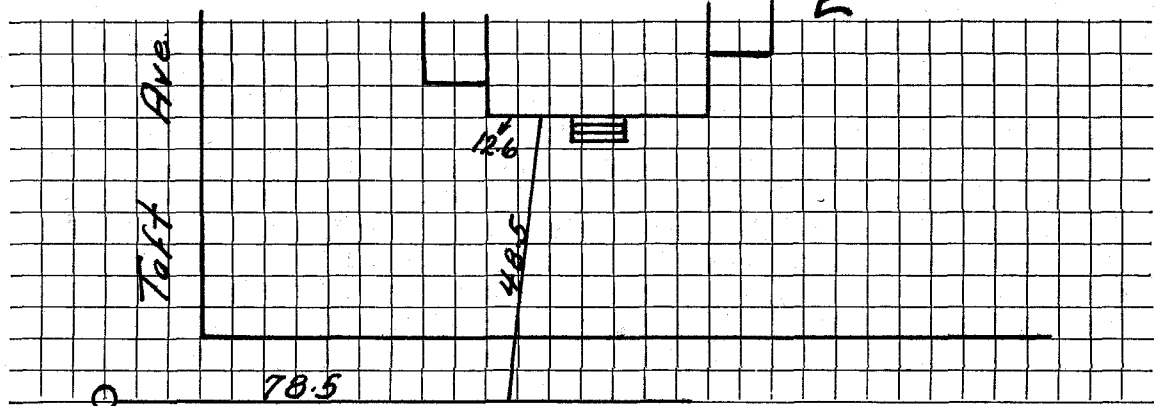

Connection made in _____ Street.

Work completed _____ 19

Remarks: