

Name

Service No.

Address 4 Stevens Road

4 Stevens Road

Location

Kind of Pipe

Size 6"

Size of Main 8"


~~REPAIR~~—Renewal—~~REPAIR~~ W.O. #704

Location

Date	Material	Amount	Total	Date		Amount
					OUTSIDE	
				8/22/79	Labor	
				3	5' Transite pipe	
				1	2' Transite Nipple	
				1	22 $\frac{1}{2}$ ^o Bend	
				1	6" x 8" Cast Iron Saddle	
				1	End Cap	
				1 $\frac{1}{2}$	Ton 3/4" Stone	
				5	yds. Gravel	
					Patch 7' x 16'	
				5 $\frac{1}{2}$	hrs. Trucking	
				2	hrs. Town Shovel	
				1	hr. Compressor	
				1	hr. Roller	

TOWN OF LEXINGTON — BOARD OF PUBLIC WORKS
SEWER DIVISION

Sketch of Service Here **4**

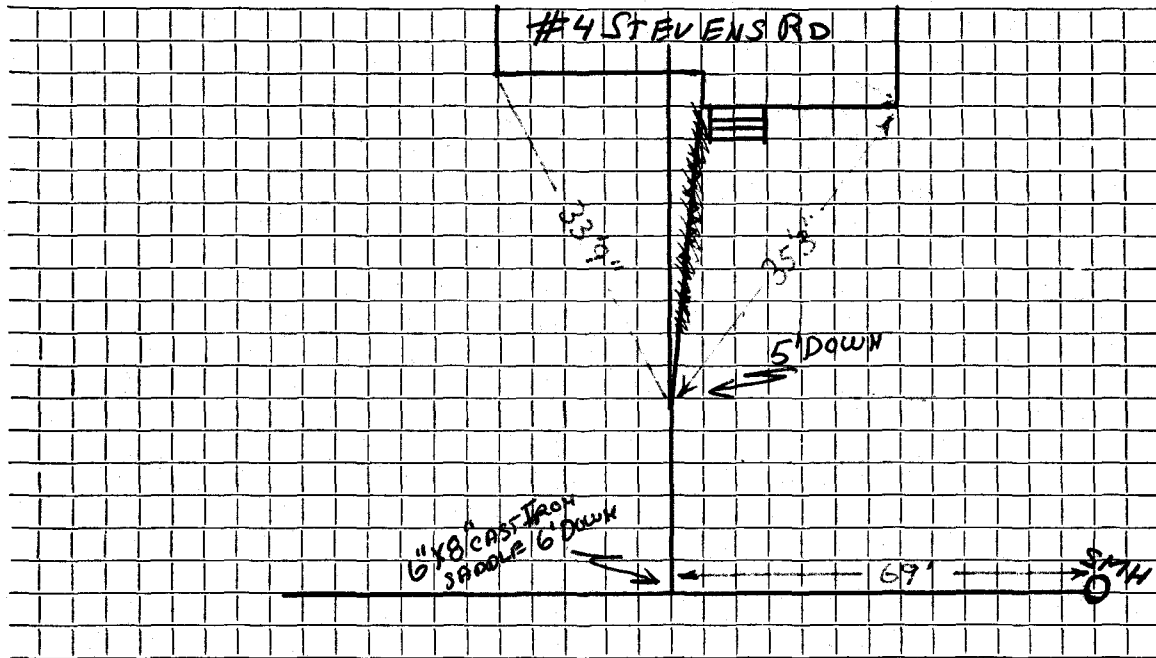

Connection made in Street. Work completed

Remarks: Original Service 4-17-36 (37'-6" Sewer Pipe.)