

Name Ivar D. Johnson

Service No. ²⁹ 127

Address ~~36 Forham St., Arlington~~

#6 Steven Rd.

Location Lot #35 ~~Gay St., Steven~~ ^{#6} ~~13~~

Kind of Pipe

Size 6"

Size of Main 8"

~~Repair~~ Renewal - New Service

Location

Date	Material	Amount	Total	Date	Amount
1936					
April 3	10 hrs. labor @ 55¢	5 50		Oct 27 35	18 00
Nov. 5-12-36	6 " " @ 60¢	3 60		Aug. 19, 1936 - Cash	6 00
# 24.00 to Russell			9 10		24 00
	40' 6" Sewer Pipe @ 17¢		6 80		
	Jointing compound		1 00		
	Trucking 2 hrs. @ 75¢		1 50		
			18 40	Billed 5/13/36	
	Say : 40' @ 60¢		\$24 00		
	Labor				

Hadley Press, Inc., Lexington

30
60
18.00

TOWN OF LEXINGTON—BOARD OF PUBLIC WORKS
SEWER DIVISION

DATE Oct 24 1935

NO. _____

The undersigned applies for the construction of a particular sewer connecting No. Lot #35 Cary st Street and hereby agrees to comply with the Rules and Regulations governing the construction and use of Particular Sewers, as now or at any future time established by the Board of Selectmen.


Am't. of Estimate \$ 18.⁰⁰

Am't. Paid \$ _____

Lois S Johnson Owner

6

Sketch of Service Here **6**

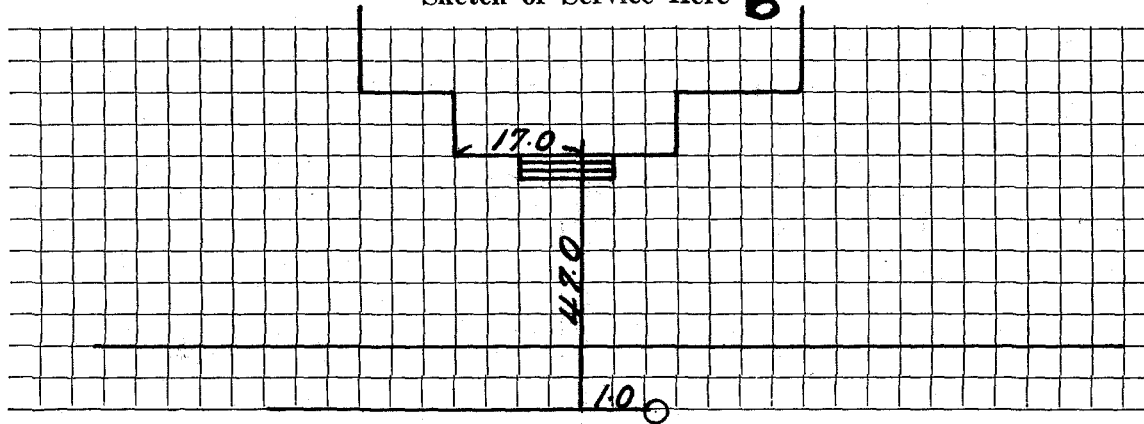

Connection made in _____ Street.

Work completed _____ 19

Remarks: